


STATE OF KANSAS
STATE CORPORATION COMMISSION

Give All Information Completely
Make Required Affidavit
Mail or Deliver Report to:
Conservation Division
State Corporation Commission
212 No. Market
Wichita, Kansas

Form CP-4
15-095-20055-0000

WELL PLUGGING RECORD

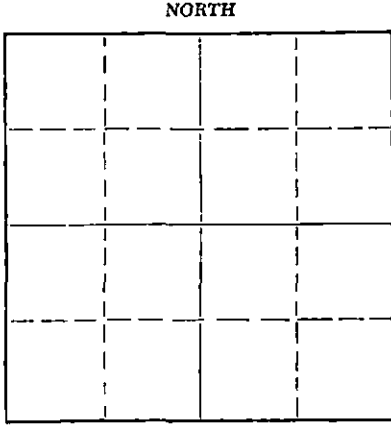

Locate well correctly on above
Section Plat

Kingman County, Sec. 18 Twp. 28S Rge. 5W (E) (W)
Location as "NE/CNW/SW" or footage from lines 330' N of SL & 660' E of WL
Lease Owner Dean & Clark, Inc.
Lease Name Krase Well No. I
Office Address 416 Union Center Bldg., Wichita, Kansas 67202
Character of Well (completed as Oil, Gas or Dry Hole) Dry hole
Date well completed December 17, 1967
Application for plugging filed December 28, 1967
Application for plugging approved 19
Plugging commenced December 17, 1967
Plugging completed December 17, 1967
Reason for abandonment of well or producing formation _____

If a producing well is abandoned, date of last production _____ 19____
Was permission obtained from the Conservation Division or its agents before plugging was commenced? Yes

Name of Conservation Agent who supervised plugging of this well A. Elving, Box 248, Pratt, Kansas
Producing formation _____ Depth to top _____ Bottom _____ Total Depth of Well _____ Feet
Show depth and thickness of all water, oil and gas formations.

OIL, GAS OR WATER RECORDS

CASING RECORD

FORMATION	CONTENT	FROM	TO	SIZE	PUT IN	PULLED OUT

Describe in detail the manner in which the well was plugged, indicating where the mud fluid was placed and the method or methods used in introducing it into the hole. If cement or other plugs were used, state the character of same and depth placed, from _____ feet to _____ feet for each plug set.

Mud to 225 ft. Set wood plug at 225 ft., 1/2 sx. hulls & 25 sx. cement.
Mud to 40 ft. Set wood plug at 40 ft., 1/2 sx. hulls & 10 sx. cement to bottom of cellar.

RECEIVED
STATE CORPORATION COMMISSION
FEB 9 - 1968
CONSERVATION DIVISION
Wichita, Kansas

(If additional description is necessary, use BACK of this sheet)

Name of Plugging Contractor Dean & Clark, Inc.
Address 416 Union Center Bldg., Wichita, Kansas 67202


STATE OF Kansas, COUNTY OF Sedgwick, ss.
Jay C. Clark, (employee of owner) or (owner or operator) of the above-described well, being first duly sworn on oath, says: That I have knowledge of the facts, statements, and matters herein contained and the log of the above-described well as filed and that the same are true and correct. So help me God.

(Signature) Jay C. Clark
416 Union Center, Wichita, Kansas
(Address)

SUBSCRIBED AND SWORN to before me this 28th day of December, 1967

Phyllis Gillen
Phyllis Gillen, Notary Public.

August 30, 1969

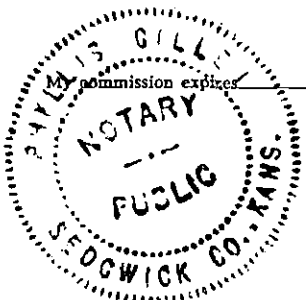

15-095-20055-0000

D R I L L E R S L O G

COMPANY: Dean & Clark, Inc.
 CONTRACTOR: Company tools
 LEASE NAME: Krase No. 1
 LOCATION: 330' N of SL & 660' E of WL,
 Section 18-28S-5W, Kingman County, Kansas
 1428' D.F. - 1431' K.B.
 ELEVATION: 8-Jts. (244') 8-5/8"
 SURFACE CASING: 12-5-67
 COMMENCED: 12-17-67
 COMPLETED: 3900 feet
 ROTARY TOTAL DEPTH:

<u>FORMATION</u>	<u>DEPTH</u>	
Red Rock	130	Spudded at 11:30 A.M. 12-6-67. Drilled 12-1/4" surface hole to 246'. Ran 8-Jts. (244') 8-5/8" surface pipe. Set at 244', cemented with 185 sx. common Sunset cement. Plug down at 7:00 P.M. 12-6-67. Cement circulated. DST #1: 3378-3388 DST #2: 3433-3454 DST #3: 3841-3865 No electric log run. Plugged hole at 3900' - 12-17-67.
Shale	246	
Shale-Shells	772	
Anhydrite	810	
Shale-Lime Streaks	984	
Lime	1029	
Shale-Lime	1117	
Lime-Shale	1560	
Shale-Lime	1705	
Shale	2065	
Shale-Lime	2295	
Shale	2595	
Lime-Shale	2885	
Shale	3065	
Lime-Shale	3127	
Lime	3197'	
Lime-Shale	3255	
Lime	3865	
Lime-Chert	3900	
R.T.D.	3900	

SAMPLE TOPS

Topeka	2390 (- 959)
Heebner	2752 (-1321)
Toronto	2767 (-1336)
Douglas Shale	2853 (-1422)
Brown Lime	2994 (-1563)
Lansing Kansas City	3037 (-1606)
Base Kansas City	3467 (-2036)
Marmaton	3547 (-2116)
Cherokee	3693 (-2262)
Mississippian Chert	3838 (-2407)
Mississippian Dolomite	3848 (-2417)
Rotary Total Depth	3900 (-2469)

RECEIVED
 STATE CORPORATION COMMISSION
 FEB 9 - 1968
 CONSERVATION DIVISION
 Wichita, Kansas

STATE OF KANSAS)
) ss:
 COUNTY OF SEDGWICK)

The undersigned, being duly sworn on oath, states that the above statement and log are a true and correct record and log of the well drilled at the location above described.



Jay C. Clark
 Jay C. Clark

Subscribed and sworn to before me this 28th day of December, 1967.

My commission expires: 8-30-69.

Phyllis Gillen
 Phyllis Gillen, Notary Public