


STATE OF KANSAS
STATE CORPORATION COMMISSION

15-095-20170-0000

WELL PLUGGING RECORD

Give All Information Completely
Make Required Affidavit
Mail or Deliver Report to
Conservation Division
State Corporation Comm.
245 North Water
Wichita, KS 67202

Kingman County, Sec. 25 Twp. 28 Rge. 6W E/W
Location as "NE/CNW $\frac{1}{4}$ /SW $\frac{1}{4}$ " or footage from lines _____
C NE SW
Lease Owner Halliburton Oil Producing Co.
Lease Name Kostner #1 Well No. _____
Office Address Oklahoma City, Oklahoma
Character of Well (Completed as Oil, Gas or Dry Hole) _____

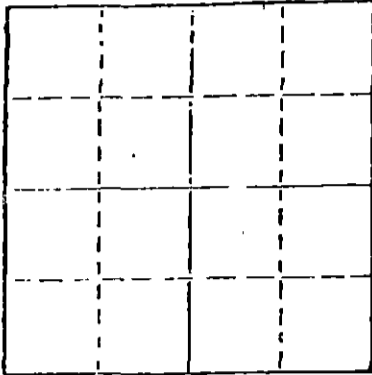

Locate well correctly on above
Section Plot

Date Well completed _____ 19____
Application for plugging filed _____ 19____
Application for plugging approved _____ 19____
Plugging commenced 11/9/78 _____ 19____
Plugging completed 3/30/79 _____ 19____
Reason for abandonment of well or producing formation
depleted
If a producing well is abandoned, date of last production _____ 19____

Was permission obtained from the Conservation Division or
its agents before plugging was commenced? yes

Name of Conservation Agent who supervised plugging of this well Owens
Producing formation _____ Depth to top _____ Bottom _____ Total Depth of Well 4286
Show depth and thickness of all water, oil and gas formations.

OIL, GAS OR WATER RECORDS

CASING RECORD

FORMATION	CONTENT	FROM	TO	SIZE	PUT IN	PULLED OUT
				8-5/8	250	none
				4 1/2"	3965	3108'

Describe in detail the manner in which the well was plugged, indicating where the mud fluid
was placed and the method or methods used in introducing it into the hold. If cement or other
plugs were used, state the character of same and depth placed, from _____ feet to
_____ feet for each plug set.

Ran sand and set 4 sacks cement to plug off bottom. Shot pipe at 3204', 3118', pulled
10 joints and it blew out, then went dead. Tried to lay more pipe down, it kept getting
wild, at 21 joints it blew out mud. Put swedge on and closed in. Pumped salt water in
well to kill well. Pulled 75 joints. Allied tried to plug well, plug container blew off
with 25 sacks cement in hole. Well will have to be drilled out.

PUMPED 5 SACKS HULLS, 25 SACKS GEL, 125 SACKS POS, 2% gel to plug well.

PLUGGING COMPLETE.

(If additional description is necessary, use BACK of this sheet)

Name of Plugging Contractor KESLO CASING PULLING
CHASE, KANSAS

STATE OF KANSAS COUNTY OF RICE, ss.
R. DARRELL KELSO (employee of owner) or (owner or operator)
of the above-described well, being first duly sworn on oath, says: That I have knowledge of
the facts, statements, and matters herein contained and the log of the above-described well
as filed and that the same are true and correct. So help me God.

(Signature) R. Darrell Kelso
CHASE, KANSAS
(Address)

SUBSCRIBED AND SWORN TO before me this 5th day of April, 19 79

Margaret Melcher
Notary Public.

My commission expires _____



RECEIVED
STATE CORPORATION COMMISSION

APR 10 1979

CONSERVATION DIVISION
Wichita, Kansas

15-095-20170-0000


WELL LOG
Kostner #1
NE SW 25-28S-6W
Kingman County, Kansas

FROM	TO	
0	60	Sand
60	780	Red Bed
780	3093	Shale and lime
3093	3540	Lime
3540	3815	Lime and shale
3815	4285	Lime
4285		Total Depth

STATE OF KANSAS

COUNTY OF BARTON ss

T. D. Sweetman, President of Sweetman Drilling, Inc., being first duly sworn on oath says: That I have knowledge of the facts, statements and matters herein contained and the log of the above described well as filed and that the same are true and correct.


T. D. Sweetman

Subscribed and sworn before me this 12th day of August, 1969.




Notary Public Barton County

RECEIVED
STATE COURTS
MAY 30 1978