

15095-20962-0000


STATE OF KANSAS
STATE CORPORATION COMMISSION

WELL PLUGGING RECORD

Give All Information Completely
Make Required Affidavit
Mail or Deliver Report to
Conservation Division
State Corporation Comm.
245 North Water
Wichita, KS 67202

Kingman County, Sec. 26 Twp. 28S Rge. 6 E/W
Location as "NE/CNW $\frac{1}{4}$ SW $\frac{1}{4}$ " or footage from lines
SW SE SW

Lease Owner Gear Petroleum Co.
Lease Name Twietmeyer Well No. 1
Office Address 300 Sutton Place, Wichita, Kansas 67202
Character of Well (Completed as Oil, Gas or Dry Hole)
Dry Hole

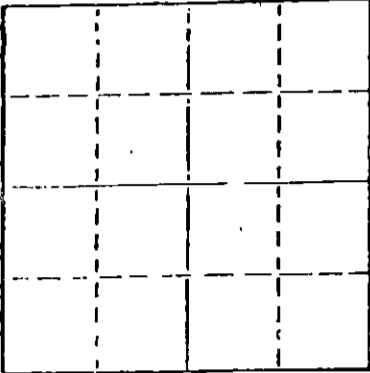

Locate well correctly on above
Section Plot

Date Well completed June 7, 19 80
Application for plugging filed June 7, 19 80
Application for plugging approved June 7, 19 80
Plugging commenced June 7, 19 80
Plugging completed June 7, 19 80
Reason for abandonment of well or producing formation

If a producing well is abandoned, date of last production 19

Was permission obtained from the Conservation Division or its agents before plugging was commenced? Yes

Name of Conservation Agent who supervised plugging of this well Wm. T. Owen, Pratt, Kansas
Producing formation Depth to top Bottom Total Depth of Well 4035
Show depth and thickness of all water, oil and gas formations.

OIL, GAS OR WATER RECORDS

CASING RECORD

FORMATION	CONTENT	FROM	TO	SIZE	PUT IN	PULLED OUT
				8-5/8"	210'	None

Describe in detail the manner in which the well was plugged, indicating where the mud fluid was placed and the method or methods used in introducing it into the hold. If cement or other plugs were used, state the character of same and depth placed, from feet to feet for each plug set.

Pumped 40 sacks cement through drill pipe to 210'. Pushed plug, & 1/2 sack hulls to 40' with 10 sacks cement. Plugged rat hole with 5 sacks cement.

(If additional description is necessary, use BACK of this sheet)

Name of Plugging Contractor Graves Drilling Co., Inc.

1980 JUN 17 06-17 80

STATE OF KANSAS COUNTY OF SEDGWICK, ss.
Betty Brandt (employee of owner) or (owner or operator)
of the above-described well, being first duly sworn on oath, says: That I have knowledge of the facts, statements, and matters herein contained and the log of the above-described well as filed and that the same are true and correct. So help me God.

(Signature) Betty Brandt
910 Union Center, Wichita, Kansas 67202
(Address)

SUBSCRIBED AND SWORN TO before me this 16th day of June, 19 80

Rebecca L. Matthews
Notary Public.

My commission expires May 17, 1983

15-095-20962-0000

ROTARY DRILLERS' LOG

OPERATOR: Gear Petroleum Co.
300 Sutton Place
Wichita, Kansas 67202

DRILLING COMMENCED: May 30, 1980

CONTRACTOR: Graves Drilling Co., Inc.
910 Union Center
Wichita, Kansas 67202

DRILLING COMPLETED: June 7, 1980

CASING RECORD: 5 Jts. 210' of new 8-5/8"
cemented with 185 sacks.

LOCATION: Twietmeyer No. 1
SW SE SW
Section 26-28S-6W
Kingman County, Kansas

0 - 210	Red bed
210 - 1300	Red bed & shale
1300 - 3980	Shale & lime
3980 - 4005	Shale & chert
4005 - 4035	Chert
4035	Rotary Total Depth

I hereby certify the foregoing statements to be true and correct to the best of my knowledge.

GRAVES DRILLING CO., INC.

By Betty Brandt
Secretary-Treasurer

RECEIVED
MINERAL CONSERVATION COMMISSION
JUN 17 1980
CONSERVATION DIVISION
Wichita, Kansas

STATE OF KANSAS)
) SS.
SEDGWICK COUNTY)

Subscribed and sworn before me, a Notary Public, this 16th day of June, 1980.

Rebecca L. Matthews
Rebecca L. Matthews Notary Public

My commission expires: May 17, 1983

