


STATE OF KANSAS
STATE CORPORATION COMMISSION

WELL PLUGGING RECORD

Give All Information Completely
Make Required Affidavit
Mail or Deliver Report to:
Conservation Division
State Corporation Commission
212 No. Market
Wichita, Kansas

NORTH

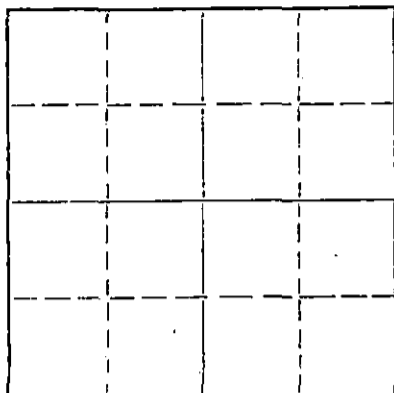

Locate well correctly on above
Section Plat

Kingman County, Sec. 29 Twp. 28S Rge. 6 (W) West
Location as "NE/CNW/SW" or footage from lines C SE SE
Lease Owner MACK OIL CO.
Lease Name Blumanhorst Well No. 1
Office Address 812 Union Center Building, Wichita, Kansas 67202
Character of Well (completed as Oil, Gas or Dry Hole) Dry Hole
Date well completed August 25 1966
Application for plugging filed August 25 1966
Application for plugging approved August 25 1966
Plugging commenced August 25 1966
Plugging completed August 25-5:00 p.m. 1966
Reason for abandonment of well or producing formation Dry

If a producing well is abandoned, date of last production 19
Was permission obtained from the Conservation Division or its agents before plugging was commenced? Yes

Name of Conservation Agent who supervised plugging of this well Archie V. Elving, Pratt, Kansas
Producing formation None Depth to top Bottom Total Depth of Well 4410 Feet
Show depth and thickness of all water, oil and gas formations.

OIL, GAS OR WATER RECORDS

CASING RECORD

FORMATION	CONTENT	FROM	TO	SIZE	PUT IN	PULLED OUT

Describe in detail the manner in which the well was plugged, indicating where the mud fluid was placed and the method or methods used in introducing it into the hole. If cement or other plugs were used, state the character of same and depth placed, from feet to feet for each plug set.

Plugged with 35 sax common cement @ 235'
20 sax common cement @ 50'
5 sax common cement @ rathole & mousehole
Plug down @ 5:00 p.m., August 25, 1966

RECEIVED
STATE CORPORATION COMMISSION

AUG 26 1966

CONSERVATION DIVISION
Wichita, Kansas

(If additional description is necessary, use BACK of this sheet)
Name of Plugging Contractor MACK OIL CO.
Address P.O. Box 400, Duncan, Oklahoma 73533

STATE OF KANSAS, COUNTY OF SEDGWICK, ss.
Robert L. Harris (employee of owner) or (owner or operator) of the above-described well, being first duly sworn on oath, says: That I have knowledge of the facts, statements, and matters herein contained and the log of the above-described well as filed and that the same are true and correct. So help me God.

(Signature) Robert L. Harris
812 Union Center Bldg., Wichita, Kansas 67202
(Address)

SUBSCRIBED AND SWORN TO before me this 25th day of August, 1966

My commission expires September 21, 1968

Elizabeth F. Nice
Notary Public.

15095-01009-0000

MACK OIL COMPANY
Duncan, Oklahoma

DRILLERS WELL LOG

#1 Blumanhorst

Commenced R. D.: 8-14-66
Completed R. D.: 8-25-66
Rotary Total Depth: 4410'

C SE SE - Section 29-28S-6W
Kingman County, Kansas
Elevation: 1484' Kelly Bushing
Initial Production: Dry
Contractor: Mack Oil Company

<u>STRATA</u>	<u>DEPTH</u>
Sand	0 - 60'
Shale	60 - 1000
Lime and Shale	1000 - 1150
Shale & Lime	1150 - 1430
Lime	1430 - 1674
Lime & Shale	1674 - 1727
Shale & Lime	1727 - 2160
Lime & Shale	2160 - 2530
Lime	2530 - 2565
Lime & Shale	2565 - 2685
Shale & Lime	2685 - 2918
Lime	2918 - 3015
Sand	3015 - 3107
Lime & Shale	3107 - 3258
Lime	3258 - 3692
Lime & Shale	3692 - 3940
Lime	3940 - 4400
Sand	4400 - 4410'

RECEIVED
STATE CORPORATION COMMISSION

AUG 26 1966

CONSERVATION DIVISION
Wichita, Kansas

I hereby certify that the above is a true and correct log of said well as reflected by the daily drilling reports.

MACK OIL COMPANY

By Robert L. Harris
Robert L. Harris

Signed and sworn to in my presence this 25th day of August, 1966, by Robert L. Harris, representative for Mack Oil Company.

Elizabeth F. Nice
Elizabeth F. Nice, Notary Public

My Commission Expires September 21, 1968