


STATE OF KANSAS
STATE CORPORATION COMMISSION
CONSERVATION DIVISION
P. O. BOX 17027
WICHITA, KANSAS 67217

FORM CP-4

WELL PLUGGING RECORD

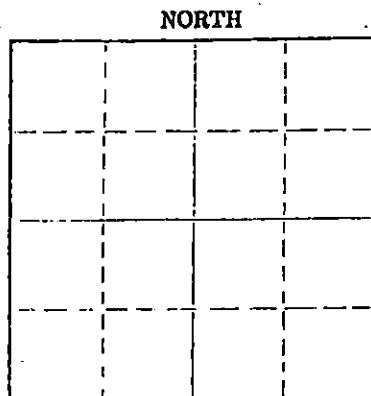

Locate well correctly on above Section Plat

Edwards County, Sec. 3 Twp. 24S Rge. 17W (EX) (W)
Location as "NE/CNW/SW" or footage from lines C NW NW
Lease Owner F. G. Holl; Barton A. Holl; Sterling Drilling Company
Lease Name F. Massey #1 Well No. 1
Office Address 6127 East Kellogg, Wichita, Kansas 67207
Character of Well (completed as Oil, Gas or Dry Hole) Dry Hole
Date well completed June 13, 1975 19
Application for plugging filed June 13, 1975 19
Application for plugging approved June 13, 1975 19
Plugging commenced 4:30 PM, June 13, 1975 19
Plugging completed 5:30 PM, June 13, 1975 19
Reason for abandonment of well or producing formation Dry Hole

If a producing well is abandoned, date of last production 19
Was permission obtained from the Conservation Division or its agents before plugging was commenced? Yes

Name of Conservation Agent who supervised plugging of this well G. R. Biberstein
Producing formation _____ Depth to top _____ Bottom _____ Total Depth of Well 4385' Feet
Show depth and thickness of all water, oil and gas formations.

OIL, GAS OR WATER RECORDS

CASING RECORD

FORMATION	CONTENT	FROM	TO	SIZE	PUT IN	PULLED OUT
				8 5/8"	251'	None

Describe in detail the manner in which the well was plugged, indicating where the mud fluid was placed and the method or methods used in introducing it into the hole. If cement or other plugs were used, state the character of same and depth placed, from _____ feet to _____ feet for each plug set.

Filled hole with heavy mud.
Fitz Heavy mud to 250' with 35 sacks through
drillpipe at 250'. Heavy mud to 40' with
solid bridge, 1/4 sacks hulls, 15 sacks to
surface, 2 sacks in rathole.

Handwritten notes: 15, 23, 25, 26

(If additional description is necessary, use BACK of this sheet)

Name of Plugging Contractor Sterling Drilling Company
Address P. O. Box 129, Sterling, Kansas 67579

STATE OF KANSAS COUNTY OF RICE ss.
F. A. Wuellner

(employee of owner) or (owner or operator) of the above-described well, being first duly sworn on oath, says: That I have knowledge of the facts, statements, and matters herein contained and the log of the above-described well as filed and that the same are true and correct. So help me God. STERLING DRILLING COMPANY

(Signature) *F. A. Wuellner*
F. A. Wuellner, Secretary
P. O. Box 129, Sterling, Kansas 67579
(Address)

SUBSCRIBED AND SWORN TO before me this 18th day of June, 1975

Bernard Laudermilk
Bernard Laudermilk, Notary Public.

My commission expires _____

BERNARD LAUDERMILK—NOTARY PUBLIC
My Commission Expires Jan. 22, 1978

STERLING DRILLING COMPANY
P. O. Box 129
Sterling, Kansas 67579

WELL LOG ----- F. MASSEY #1

Located: C NW NW, Section 3-24S-17W, Edwards County, Kansas

OWNER: F. G. Holl, Barton A. Holl, Sterling Drilling Company
ROTARY DRILLING CONTRACTOR: Sterling Drilling Company

COMMENCED: June 4, 1975
COMPLETED: June 13, 1975

TOTAL DEPTH: 4385'

LOG	CASING RECORD
0 - 98 Sand and Clay	Ran 6 joints 8 5/8", 28#, 8rd, Rge 3 used casing, 240.88' set at 251' K.B. with 225 sacks 60/40 Pozmix with 3% cc. Plug down at 4:45 PM, 6-4-75.
98 - 253 Shale and Sand Stringers	
253 - 900 Shale, Shells, Sand, Shale	
900 - 1128 Red Bed	
1128 - 1148 Anhydrite	
1148 - 1640 Shale, Shells and Salt	
1640 - 2105 Shale and Shells	
2115 - 3250 Lime and Shale	
3250 - 3720 Lime	
3720 - 3840 Lime with Shale	
3840 - 4110 Lime	
4110 - 4365 Lime and Shale	
4365 - 4385 Lime	Flugged.

RECEIVED
STATE CORPORATION COMMISSION
JUN 23 1975
CONSERVATION DIVISION
Wichita, Kansas