

STATE OF KANSAS
STATE CORPORATION COMMISSION

WELL PLUGGING RECORD

Give All Information Completely
Make Required Affidavit
Mail or Deliver Report to:
Conservation Division
State Corporation Commission
211 No. Broadway
Wichita, Kansas

Edwards County, Sec. 3 Twp. 24S Rge. 17 (E) 17 (W)

Location as "NE/CNWSW" or footage from lines SE SE NE

Lease Owner Petroleum Management, Inc., For Walter P. Innes et al

Lease Name Massey Well No. 1

Office Address 1019 Central Building, Wichita, Ks.

Character of Well (completed as Oil, Gas or Dry Hole) oil

Date well completed August 3, 1957

Application for plugging filed December 26 1958

Application for plugging approved December 30 1958


Plugging commenced December 22 1958

Plugging completed January 2 1959

Reason for abandonment of well or producing formation Depleted

If a producing well is abandoned, date of last production December 20, 1958

Was permission obtained from the Conservation Division or its agents before plugging was commenced? Yes

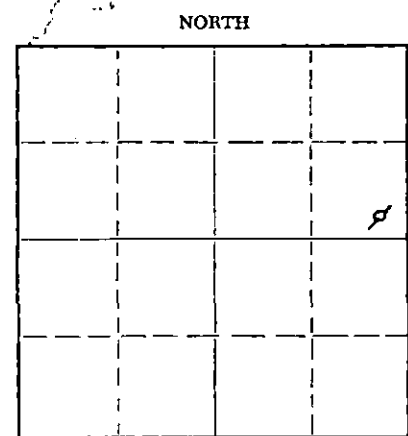

Locate well correctly on above Section Plat

Name of Conservation Agent who supervised plugging of this well Unknown

Producing formation Mississippi Depth to top 4278 Bottom 4441 Total Depth of Well 4441 Feet

Show depth and thickness of all water, oil and gas formations.

OIL, GAS OR WATER RECORDS

CASING RECORD

FORMATION	CONTENT	FROM	TO	SIZE	PUT IN	PULLED OUT
Mississippi	Oil	No known		878'	245	none
				5 1/2"	4484	3430

Describe in detail the manner in which the well was plugged, indicating where the mud fluid was placed and the method or methods used in introducing it into the hole. If cement or other plugs were used, state the character of same and depth placed, from _____ feet to _____ feet for each plug set.

Filled 5 1/2" OD casing with chat from 4441 ft. to 4260 ft. and dumped 5 sacks cement. Shot pipe lose at 3430 ft. Pulled pipe out and mudded to 245 ft. Set 5 ft. rock bridge, dumped 20 sacks of cement with mud up to 40 ft., set 10 ft. rock bridge and filled to base of cellar with 10 sacks cement.

RECEIVED
STATE CORPORATION COMMISSION

JAN 29 1959

CONSERVATION DIVISION
Wichita, Kansas

(If additional description is necessary, use BACK of this sheet)

Name of Plugging Contractor Arnett Casing Pulling Company

Address 172 West 3rd Street, Hoisington, Kansas

STATE OF Kansas, COUNTY OF Sedgwick, ss.

John W. Ritchey (employee of owner) or (owner or operator) of the above-described well, being first duly sworn on oath, says: That I have knowledge of the facts, statements, and matters herein contained and the log of the above-described well as filed and that the same are true and correct. So help me God.

(Signature) John W. Ritchey

1019 Central Building, Wichita, Kansas (Address)

SUBSCRIBED AND SWORN TO before me this 27th day of January, 1959

Mare O. Murphy
Notary Public.

My commission expires April 23, 1962

PLUGGING
FILE SEC 3 T 24 R 17 W
BOOK PAGE 6 LINE 6

ROTARY DRILLING LOG

Contract: Prime Drilling Company
 Hoosier No. 1
 Sec. 3-7b-177,
 Edwards County, Kansas

Contract No: Prime Drilling Company
 Date: 6/27/57
 Well: 7/17/57

Formations:

Remarks: Set 4-5/8" surface casing
 at 24' cemented with 200 sacks cement,
 25 S.C.

Sand	1 0'
Clay & Shale	150'
Shale & Shells	300'
Shale	450'
Red bed	600'
Sand	800'
Red bed & shale	1115'
Anhydrite	1150'
Red bed, shale & shell	1135'
Shale & shells	2030'
Lime & shale	2180'
Sandy lime & shale	2270'
Lime	2390'
Lime & shale	2600'
Lime	2695'
Lime & shale	2715'
Lime	2810'
Lime & shale	3520'
Lime	3570'
Lime & shale	3620'
Lime	3740'
Lime & shale	3800'
Lime	4000'
Lime, Chert, sand	4100'
Chert	4325'
Chert, lime & shale	4500'
Lime & shale	4835'
Shale, sand, lime	5100'
Shale, chert, sand	5115'
Shale, chert & lime	5180'
Lime, chert & shale	5195'
Rotary Total Depth	5250'

RECEIVED
 STATE CORPORATION COMMISSION

JAN 29 1959

CONSERVATION DIVISION
 Topeka, Kansas

Set 5-1/2" production casing at 5140'
 cemented with 125 sacks Common Cement.

We certify the above log is true and
 correct to the best of our knowledge
 and belief.

PRIME DRILLING COMPANY

R. T. Medical

PLUGGING
 FILE SEC. 3 T. 24 R. 17W
 BOOK PAGE 6 LINE 16