

STATE OF KANSAS
STATE CORPORATION COMMISSION

Give Alt. Information Completely
Make Reg. and Affidavit
Mail Deliver Report to:
Conservation Division
State Corporation Commission
211 No. Broadway
Wichita, Kansas

WELL PLUGGING RECORD

Hodgeman County, Sec. 7 Twp. 24S Rge. (E) (W) 21

Location as "NE/CNW/SW" or footage from lines SE SW

Lease Owner James W. Hershberger

Lease Name Dvorck Well No. 1

Office Address 1039 1st National Bldg, Wichita, Kans.

Character of Well (completed as Oil, Gas or Dry Hole) Dry hole

Date well completed 2/23 19 64

Application for plugging filed 2/23 19 64

Application for plugging approved 2/23 19 64


Plugging commenced 2/23 19 64

Plugging completed 2/23 19 64

Reason for abandonment of well or producing formation Dry hole

If a producing well is abandoned, date of last production 19

Was permission obtained from the Conservation Division or its agents before plugging was commenced? yes

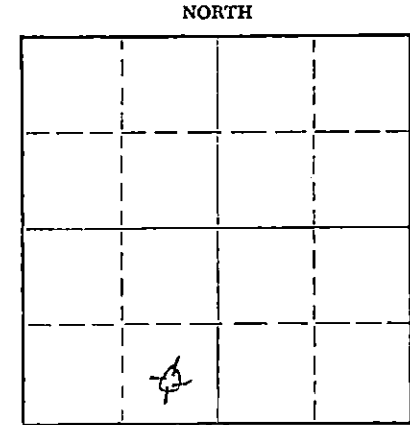

Locate well correctly on above Section Flat

Name of Conservation Agent who supervised plugging of this well Hugh Scott

Producing formation Dry hole Depth to top Bottom Total Depth of Well 4911 Feet

Show depth and thickness of all water, oil and gas formations.

OIL, GAS OR WATER RECORDS

CASING RECORD

FORMATION	CONTENT	FROM	TO	SIZE	PUT IN	PULLED OUT
Lansing	water	4105	4492	8 5/8"	297	None
Mississippi	water	4723	4911			

Describe in detail the manner in which the well was plugged, indicating where the mud fluid was placed and the method or methods used in introducing it into the hole. If cement or other plugs were used, state the character of same and depth placed, from feet to feet for each plug set.

Mud to 700', pump cement plug w/25 sax
plug @ 290 w/25 sax
plug @ 40' w/ hulls & 15 sax

RECEIVED
STATE CORPORATION COMMISSION

MAR 9 1964 3-9-64

CONSERVATION DIVISION
Wichita, Kansas

Name of Plugging Contractor Rotary Hole (If additional description is necessary, use BACK of this sheet)
Address

STATE OF Florida, COUNTY OF Dade, ss.
Joseph Teichman (employee of owner) or (owner or operator) of the above-described well, being first duly sworn on oath, says: That I have knowledge of the facts, statements, and matters herein contained and the log of the above-described well as filed and that the same are true and correct. So help me God.

(Signature) [Signature] 6045 Pine Tree Dr., Miami Beach, Fla. (Address)

SUBSCRIBED AND SWORN TO before me this 4th day of March, 1964

NOTARY PUBLIC STATE OF FLORIDA a. LARGE
MY COMMISSION EXPIRES JAN. 26, 1968
BONDED THROUGH FRED W. DIESTELHORST

[Signature] Notary Public.

My commission expires

SHOLOM DRILLING COMPANY, INC.
 6045 Pine Tree Drive
 Miami Beach, Florida 33140

COMPANY: James W. Hershberger Oil Co.
 FARM: Dvorck
 LOCATION: SE SW Sec 7 T24S R21W, Hodgeman County, Kansas
 ROTARY DRILLING CONTRACTOR: Sholom Drilling Co., Inc.

COMMENCED: 2/8/64
 COMPLETED: 2/23/64
 I. P.: D & A

Elevation:
 Rotary T. D.: 4911
 Casing Record:
 8 5/8" @ 297' W/160 sax

L O G

0 - 50 Clay
 50 - 90 Sand
 90 - 297 Shale, shells & sand streaks
 297 - 375 Shale
 375 - 635 Shale & shells
 635 - 840 Red bed & shale
 840 - 845 Anhydrite
 845 - 860 Gypsum
 860 - 965 Shale & shells
 965 - 1095 Sand
 1095 - 1510 Shale & shells
 1510 - 1542 Anhydrite
 1542 - 2345 Shale & shells
 2345 - 2465 Shale & lime streaks
 2465 - 2870 Lime
 2870 - 4130 Lime & shale
 4130 - 4662 Lime
 4662 - 4700 Lime & shale
 4700 - 4764 Lime, shale & chert
 4764 - 4911 Lime
 4911 LTD

DST #1
 4724-4757 Rec. 40' OCM
 30" 18HP 872#, FBHP 307#
 FP 41-41

DST #2
 4733-4747 Rec 115' slightly
 OCM, 120' water. 18HP 1396#
 FBHP 1055#, FP 83-149

Relex Gamma-Guard, Integrated
 Acoustic-Caliper Log run to
 T. D.

RECEIVED
 STATE CORPORATION COMMISSION

MAR 9 1964

CONSERVATION DIVISION
 Wichita, Kansas

STATE OF FLORIDA)
) ss.
 COUNTY OF DADE)

I, Joseph Teichman, President of Sholom Drilling Company, Inc.
 a corporation of the State of Oklahoma, domesticated in the State of
 Kansas, being first duly sworn under oath, says: That I have
 knowledge of the facts, statements, and matters herein contained of the
 above described well as filed and that the same are true and correct.

Joseph Teichman

 Joseph Teichman

Subscribed and sworn to before me this 11th day of March, 1964

Bruce Neubauer

 Notary Public

NOTARY PUBLIC STATE OF FLORIDA at LARGE
 MY COMMISSION EXPIRES JAN. 26, 1968
 BONDED THROUGH FRED W. DIESTELHORST

My commission expires _____