


WELL PLUGGING RECORD

Give All Information Completely
Make Required Affidavit
Mail or Deliver Report to:
Conservation Division
State Corporation Commission
211 No. Broadway
Wichita, Kansas

Hodgeman County. Sec. 20 Twp. 24S Rge. 21W (E) (W)
Location as "NE/CNW/SW" or footage from lines C-NE-SE
Lease Owner Sunray DX Oil Company
Lease Name Margaret Tenbrink Well No. 1
Office Address 321 West Douglas, Wichita 2, Kansas
Character of Well (completed as Oil, Gas or Dry Hole) Dry Hole
Date well completed _____ 19____
Application for plugging filed April 17, 19 63
Application for plugging approved April 18, 19 63
Plugging commenced April 16, 19 63
Plugging completed April 16, 19 63
Reason for abandonment of well or producing formation Non Commerical

NORTH

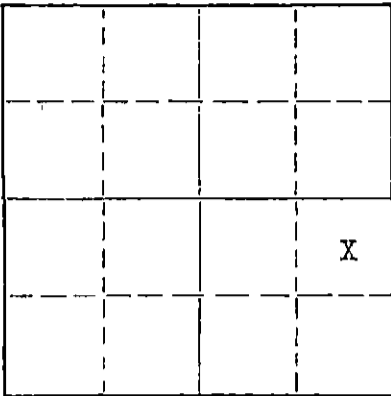

Locate well correctly on above
Section Plat

If a producing well is abandoned, date of last production _____ 19____
Was permission obtained from the Conservation Division or its agents before plugging was commenced? Yes

Name of Conservation Agent who supervised plugging of this well Mr. Hugh Scott, Sublette, Kansas
Producing formation _____ Depth to top _____ Bottom _____ Total Depth of Well 4945' Feet
Show depth and thickness of all water, oil and gas formations.

OIL, GAS OR WATER RECORDS

CASING RECORD

| FORMATION | CONTENT | FROM | TO | SIZE | PUT IN | PULLED OUT |
|------------------|---------|------|------|--------|--------|------------|
| Lsg. Kansas City | Water | 4109 | 4480 | 8 5/8" | 252' | 0' |
| Marmaton | Water | 4505 | 4636 | | | |
| Mississippi | Water | 4731 | 4945 | | | |
| | | | | | | |
| | | | | | | |
| | | | | | | |

Describe in detail the manner in which the well was plugged, indicating where the mud fluid was placed and the method or methods used in introducing it into the hole. If cement or other plugs were used, state the character of same and depth placed, from _____ feet to _____ feet for each plug set.

Filled hole with heavy mud from total depth to 240'. Placed 1/3 Sack of hulls at 240' with 30 sacks of cement on top. Filled with mud to 40' and placed 1/3 sack of hulls with 15 sacks of cement on top to surface. Dumped 5 sacks of cement in rat hole. Well Plugged and abandoned.

RECEIVED
STATE CORPORATION COMMISSION

APR 25 1963

CONSERVATION DIVISION
Wichita, Kansas

(If additional description is necessary, use BACK of this sheet)
Name of Plugging Contractor Stickle Drilling Company
Address 1100 Biting Building, Wichita, Kansas

STATE OF Kansas, COUNTY OF Sedgwick, ss.
Gary W. Pierce (employee of owner) or (owner) of the above-described

well, being first duly sworn on oath, says: That I have knowledge of the facts, statements, and matters herein contained and the log of the above-described well as filed and that the same are true and correct. So help me God.

(Signature) Gary W. Pierce
321 West Douglas, Wichita 2, Kansas
(Address)

SUBSCRIBED AND SWORN TO before me this 23rd day of April, 19 63

My commission expires July 13, 1963
W. M. Montgomery Notary Public.

Sunray DX Oil Company
Tulsa, Oklahoma

Tulsa, Oklahoma
April 19, 1963

Contractor: Stickle Drilling Company
Date Commenced: April 4, 1963
Date Completed: April 16, 1963

Margaret Tenbrink No. 1
NE SE Sec. 20-24S-21W
Hodgeman County, Kans.

DRILLER'S LOG

Depth Figures Indicate Base of Formation:

| | |
|------------------------|---------|
| Surface soil and shale | 80 |
| Sand | 105 |
| Shale | 253 |
| Shale and sand | 1500 |
| Shale | 2210 |
| Shale and lime | 2446 |
| Lime and shale | 2806 |
| Lime | 2830 |
| Lime and shale | 3039 |
| Shale | 3185 |
| Shale and lime | 3645 |
| Lime and shale | 3827 |
| Shale and lime | 4135 |
| Lime and shale | 4288 |
| Lime | 4880 |
| Lime and chert | 4913 |
| Lime | 4945 TD |

I, Fred E. Stickle, hereby certify the above to be a true and complete Driller's Log of Sunray DX Oil Company's Margaret Tenbrink, No. 1, NE SE Section 20-24S-21W, Hodgeman County, Kansas.

Fred E. Stickle
FRED E. STICKLE

M. Mensley
Notary Public

My Commission Expires January 11, 1967

RECEIVED
STATE CORPORATION COMMISSION

APR 25 1963

CONSERVATION DIVISION
Wichita, Kansas