


STATE OF KANSAS
STATE CORPORATION COMMISSION

Give All Information Completely
Make Required Affidavit
Mail or Deliver Report to:
Conservation Division
State Corporation Commission
211 No. Broadway
Wichita, Kansas

Re
WELL PLUGGING RECORD

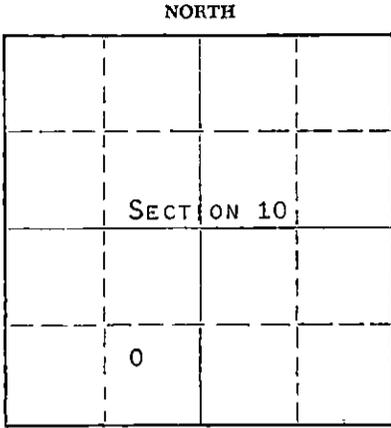

Locate well correctly on above
Section Plat

STAFFORD County, Sec. 10 Twp. 25s Rge. 14w (#) (W)
Location as "NE/CNW/SW" or footage from lines APPROX. E/2 SW NW
Lease Owner PETROLEUM, INC.
Lease Name COLLINS "B" Well No. 4
Office Address ROUTE 2, GREAT BEND, KANSAS
Character of Well (completed as Oil, Gas or Dry Hole) DRY HOLE
Date well completed NOVEMBER 14 19 60
Application for plugging filed NOVEMBER 14 19 60
Application for plugging approved NOVEMBER 14 19 60
Plugging commenced NOVEMBER 14 19 60
Plugging completed NOVEMBER 14 19 60
Reason for abandonment of well or producing formation NO PRODUCIBLE ZONES

If a producing well is abandoned, date of last production 19
Was permission obtained from the Conservation Division or its agents before plugging was commenced? YES

Name of Conservation Agent who supervised plugging of this well FRANK BROADFOOT, ST. JOHN, KANSAS
Producing formation --- Depth to top --- Bottom --- Total Depth of Well 4199 Feet
Show depth and thickness of all water, oil and gas formations.

OIL, GAS OR WATER RECORDS

CASING RECORD

FORMATION	CONTENT	FROM	TO	SIZE	PUT IN	PULLED OUT
				8-5/8"	294'	NONE

Describe in detail the manner in which the well was plugged, indicating where the mud fluid was placed and the method or methods used in introducing it into the hole. If cement or other plugs were used, state the character of same and depth placed, from --- feet to --- feet for each plug set.

MUDDED UP WITH HEAVY MUD TO 280' FOLLOWED BY A WOODEN PLUG. PLACED 20 SACKS OF CEMENT THRU DRILL PIPE ON TOP OF WOODEN PLUG. MUDDED UP WITH HEAVY MUD TO 35' FOLLOWED BY A WOODEN PLUG. PLACED 10 SACKS OF CEMENT ON TOP OF THE WOODEN PLUG TO BASE OF WELL CELLAR.

DEC 1 1960
CONSERVATION DIVISION
Wichita, Kansas

(If additional description is necessary, use BACK of this sheet)
Name of Plugging Contractor GARVEY DRILLING COMPANY
Address RURAL ROUTE 2, GREAT BEND, KANSAS

STATE OF KANSAS, COUNTY OF BARTON, ss.
DON SEARLE (employee of owner) or (owner or operator) of the above-described well, being first duly sworn on oath, says: That I have knowledge of the facts, statements, and matters herein contained and the log of the above-described well as filed and that the same are true and correct. So help me God.

(Signature) *Don Searle*
ROUTE 2, GREAT BEND, KANSAS
(Address)

SUBSCRIBED AND SWORN TO before me this 30TH day of NOVEMBER, 19 60

My commission expires APRIL 14, 1963
Arthur J. Nile
Notary Public.



WELL LOG

15-185-11926-0000

COMPANY PETROLEUM, INCORPORATED

SEC. 10 T.25S R. 14W

FARM COLLINS "B" NO. 4


LOC. Approx. E/2, SW, NW

TOTAL DEPTH 4199'

COUNTY STAFFORD CO., KANSAS

COMM. November 2, 1960 COMP. November 14, 1960

CONTRACTOR GARVEY DRILLING COMPANY

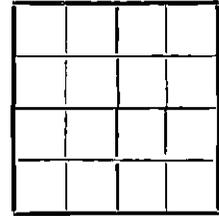

CASING 8 5/8" @ 294' w/225 sax.

ELEVATION 1962' KB

PRODUCTION D & A

FIGURES INDICATE BOTTOM OF FORMATIONS

160	Sand & clay
850	Red bed & shale
875k	Anhydrite
1510	Shale & shells
3175	Shale & lime
3390	Lime & shale
4199	Lime
4199	T. D.

SEEN
 DEC 1 1960
 CONSERVATION DIVISION
 Wichita, Kansas

State of KANSAS }
 County of BARTON } ss.

I, VERNE A. MORRIS of GARVEY DRILLING COMPANY

upon oath state that the above and foregoing is a true and correct copy of the log of the #4 COLLINS "B" well

Verne A. Morris

Subscribed and sworn to before me this 28th day of November 1960

My Commission Expires: April 14, 1963

Arthur J. Wiles
 NOTARY PUBLIC