

15-047-20602-0060


STATE OF KANSAS
STATE CORPORATION COMMISSION

WELL PLUGGING RECORD

Give All Information Completely
Make Required Affidavit
Mail or Deliver Report to
Conservation Division
State Corporation Comm.
245 North Water
Wichita, KS 67202

Edwards County, Sec. 28 Twp. 24S Rge. 17W E/W
Location as "NE/CNW/SW" or footage from lines
NE NE NW

Lease Owner F. G. Holl, et al
Lease Name Mundhenke "B" 1-28 Well No. 1-28
Office Address 6427 East Kellogg, Wichita, Kansas 67207
Character of Well (Completed as Oil, Gas or Dry Hole)

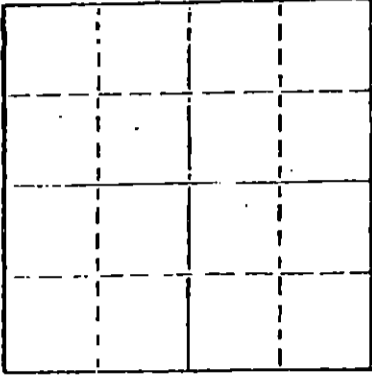

Locate well correctly on above
Section Plat

Dry Hole
Date Well completed December 6, 19 79
Application for plugging filed December 6, 19 79
Application for plugging approved December 6, 19 79
Plugging commenced 12:01 PM, December 6, 19 79
Plugging completed 1:30 PM, December 6, 19 79
Reason for abandonment of well or producing formation

Dry Hole
If a producing well is abandoned, date of last production 19

Was permission obtained from the Conservation Division or its agents before plugging was commenced? Yes

Name of Conservation Agent who supervised plugging of this well Wm. T. Owen
Producing formation Depth to top Bottom Total Depth of Well 4550'
Show depth and thickness of all water, oil and gas formations.

OIL, GAS OR WATER RECORDS

CASING RECORD

FORMATION	CONTENT	FROM	TO	SIZE	PUT IN	PULLED OUT
				8 5/8"	272.83'	None

Describe in detail the manner in which the well was plugged, indicating where the mud fluid was placed and the method or methods used in introducing it into the hold. If cement or other plugs were used, state the character of same and depth placed, from feet to feet for each plug set.

Filled hole with heavy mud.
40 sacks cement at 540' through open ended drill pipe;
heavy mud and 40 sacks cement at 270' through open ended
drill pipe; heavy mud from 270' to 40' with 1/2 sack
hulls, wood plug and solid bridge, 10 sacks cement to
surface and 5 sacks in rathole. Used 50/50 Pozmix with
2% gel.

(If additional description is necessary, use BACK of this sheet)

Name of Plugging Contractor Sterling Drilling Company, P. O. Box 129, Sterling, Kansas 67579

STATE OF KANSAS COUNTY OF RICE, ss.

F. A. Wuellner (employee of owner) or (owner or operator)
of the above-described well, being first duly sworn on oath, says: That I have knowledge of the facts, statements, and matters herein contained and the log of the above-described well as filed and that the same are true and correct. So help me God.

STERLING DRILLING COMPANY
(Signature) F. A. Wuellner, Secretary
P. O. Box 129, Sterling, Kansas 67579
(Address)

SUBSCRIBED AND SWORN TO before me this 8th day of December, 19 79

CHARLES M. HALL
Rice County, Ks.
My Appt. Exp. Jan. 31, 1982

Charles M. Hall, Notary Public.

My commission expires

RECEIVED
STATE CORPORATION COMMISSION

DEC 20 1979

CONSERVATION DIVISION
Wichita, Kansas

STERLING DRILLING COMPANY
 P. O. Box 129
 Sterling, Kansas 67579

WELL LOG - - - - - MUNDHENKE "B" 1-28
 Located: NE NE NW, Section 28-24S-17W, Edwards County, Kansas

OWNER: F. G. Holl, et al
 ROTARY DRILLING CONTRACTOR: Sterling Drilling Company

COMMENCED: November 30, 1979
 COMPLETED: December 6, 1979

TOTAL DEPTH: 4550'

<u>LOG</u>	
0 - 135	Surface Soil and Sand
135 - 275	Shale
275 - 950	Red Beds and Sand
950 - 1134	Red Bed
1134 - 1152	Anhydrite
1152 - 1805	Shale and Shells
1805 - 2225	Shale and Lime Strs.
2225 - 3015	Lime and Shale
3015 - 3265	Lime
3265 - 4415	Lime and Shale
4415 - 4448	Miss. Chert
4448 - 4455	Shale and Sand
4455 - 4550	Lime

CASING RECORD

Ran 8 joints used 8 5/8" casing, 260.83' set at 272.83' K.B. Cemented with 225 sacks 60/40 Pozmix with 3% cc. Plug down at 6:45 PM, 11-30-79, by Howco.

Plugged.

RECEIVED
 STATE CORPORATION COMMISSION

DEC 20 1979

CONSERVATION DIVISION
 Wichita, Kansas

Deviation Surveys: 3/4° at 2225'
 1 3/4° at 4448'

f