


STATE OF KANSAS  
STATE CORPORATION COMMISSION

Form CP-4

WELL PLUGGING RECORD

Give All Information Completely  
Make Required Affidavit  
Mail or Deliver Report to:  
Conservation Division  
State Corporation Commission  
P. O. Box 17027  
Wichita, Kansas 67217  
NORTH

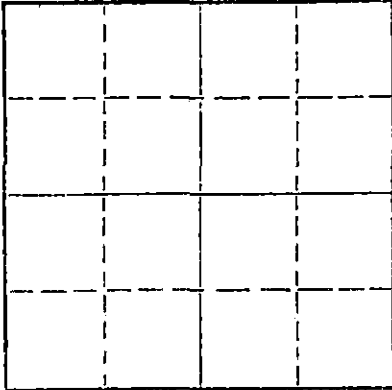

Locate well correctly on above  
Section Plat

Edwards County. Sec. 1 Twp. 24 Rge. 33S (E) 20W  
Location as "NE/CNW/SW" or footage from lines C SW NE  
Lease Owner Chaparral Exploration Co.  
Lease Name Frank Herrman Well No. 1  
Office Address P. O. Box 2041, Abilene, Texas 79604  
Character of Well (completed as Oil, Gas or Dry Hole) Dry Hole  
Date well completed 4-29 19 72  
Application for plugging filed 4-29 19 72  
Application for plugging approved 4-29 19 72  
Plugging commenced 4-29 19 72  
Plugging completed 4-29 19 72  
Reason for abandonment of well or producing formation No commercial quantities of oil or gas encountered.  
If a producing well is abandoned, date of last production 19  
Was permission obtained from the Conservation Division or its agents before plugging was commenced? Yes

Name of Conservation Agent who supervised plugging of this well Archie V. Elving  
Producing formation \_\_\_\_\_ Depth to top \_\_\_\_\_ Bottom \_\_\_\_\_ Total Depth of Well 3686 Feet  
Show depth and thickness of all water, oil and gas formations.

OIL, GAS OR WATER RECORDS

CASING RECORD

FORMATION	CONTENT	FROM	TO	SIZE	PUT IN	PULLED OUT
Surface Hole	Water	Surface	250'	8-5/8"	242'	None

Describe in detail the manner in which the well was plugged, indicating where the mud fluid was placed and the method or methods used in introducing it into the hole. If cement or other plugs were used, state the character of same and depth placed, from \_\_\_\_\_ feet to \_\_\_\_\_ feet for each plug set.

Fluid to 300', plug, 50 sx cement;  
Fluid to 240', plug, 25 sx cement;  
Fluid to 40', plug, 10 sx cement.

RECEIVED  
STATE CORPORATION COMMISSION  
MAY 2 - 1972  
CONSERVATION DIVISION  
Wichita, Kansas

(If additional description is necessary, use BACK of this sheet)

Name of Plugging Contractor D N B DRILLING, INC.  
Address 737 First National Bank Bldg., Wichita, Kansas 67202

STATE OF Kansas, COUNTY OF \_\_\_\_\_, ss.  
JAMES L. DONELSON (employee of owner) or (owner or operator) of the above-described well, being first duly sworn on oath, says: That I have knowledge of the facts, statements, and matters herein contained and the log of the above-described well as filed and that the same are true and correct. So help me God.

(Signature) James L. Donelson  
737 First Nat'l Bank Bldg., Wichita, Ks.  
(Address)

SUBSCRIBED AND SWORN TO before me this 1st day of May, 19 72

My commission expires August 25, 1972

Ella Pries  
Ella Pries  
Notary Public.

RECEIVED  
STATE CORPORATION COMMISSION  
MAY 2 - 1972  
CONSERVATION DIVISION  
Wichita, Kansas

DRILLERS' LOG

CHAPARRAL EXPLORATION CO.  
No. 1 Frank Herrman  
C SW NE, Sec. 1-24S-20W  
Edwards County, Kansas

Elev: 2242 R.B.

Commenced: 4-23-72  
Completed: 4-29-72

Surface Casing: 242.52' of  
8-5/8" cemented w/190 sx cement,  
2% cc. 4-23-72

<u>FORMATION</u>	<u>DEPTH</u>
Surface Hole	0 - 250
Shale	250 - 678
Shale & Red Bed	678 - 850
Sand & Shale	850 - 1000
Red Bed	1000 - 1376
Anhydrite	1376 - 1396
Shale & Shells	1396 - 1730
Shale & Salt	1730 - 2225
Lime & Shale	2225 - 2330
Lime	2330 - 3215
Lime & Shale	3215 - 3380
Lime	3380 - 3686 T.D.

I do hereby certify that the foregoing statements are true and correct to the best of my knowledge and belief.

D N B DRILLING, INC.

*James L. Donelson*  
JAMES L. DONELSON

STATE OF KANSAS: ss:

Subscribed and sworn to before me, the undersigned, a Notary Public in and for said state, this 1st day of May, 1972.

My Commission Expires:  
August 25, 1972

*Ella Priess*  
Ella Priess, Notary Public