


Give All Information Completely
Make Required Affidavit
Mail or Deliver Report to:
Conservation Division
State Corporation Commission
211 No. Broadway
Wichita, Kansas

WELL PLUGGING RECORD

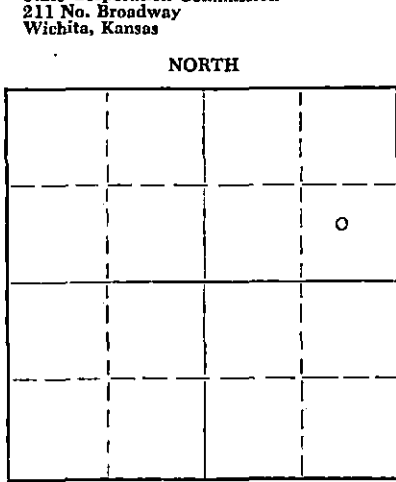

Locate well correctly on above
Section Plat

Edwards County, Sec. 4 Twp. 24S Rge. (E) 20 (W)
Location as "NE/CNW/SW" or footage from lines C SE/4 NE/4
Lease Owner D. E. Dunne, Jr.
Lease Name Dockendorf Well No. 1
Office Address 1005 Central Building, Wichita, Kansas
Character of Well (completed as Oil, Gas or Dry Hole) Dry Hole
Date well completed 11-12 19 57
Application for plugging filed 11-13 19 57
Application for plugging approved 11-18 19 57
Plugging commenced 11-13 19 57
Plugging completed 11-13 19 57
Reason for abandonment of well or producing formation
Dry Hole
If a producing well is abandoned, date of last production 19
Was permission obtained from the Conservation Division or its agents before plugging was commenced? Yes

Name of Conservation Agent who supervised plugging of this well M. A. Rives, Box 8, Pratt, Kansas
Producing formation Depth to top Bottom Total Depth of Well 4870 Feet
Show depth and thickness of all water, oil and gas formations.

OIL, GAS OR WATER RECORDS

CASING RECORD

FORMATION	CONTENT	FROM	TO	SIZE	PUT IN	PULLED OUT
				8 5/8"	223.58'	

Describe in detail the manner in which the well was plugged, indicating where the mud fluid was placed and the method or methods used in introducing it into the hole. If cement or other plugs were used, state the character of same and depth placed, from feet to feet for each plug set.

Gun up pits and circulated 1 hour. Stand 220' pipe back in derrick. Come out laying down. Fill hole with heavy rotary mud 221' from top. Set plug with 1/3 sack hulls and push down with drill pipe to top of mud. Cement with 20 sacks mixed through drill pipe. Fill hole up to 35' of base of collar and set plug on top of mud. Cement with 10 sacks cement.

RECEIVED
STATE CORPORATION COMMISSION
NOV 20 1957
CONSERVATION DIVISION
Wichita, Kansas

(If additional description is necessary, use BACK of this sheet)
Name of Plugging Contractor Twin Drilling, Inc.
Address 1005 Central Building, Wichita, Kansas

STATE OF Kansas, COUNTY OF Sedgwick, ss.
Almeda Day (employee of owner) or (owner or operator) of the above-described well, being first duly sworn on oath, says: That I have knowledge of the facts, statements, and matters herein contained and the log of the above-described well as filed and that the same are true and correct. So help me God.

(Signature) Almeda Day
1005 Central Building, Wichita, Kansas
(Address)

SUBSCRIBED AND SWORN to before me this 19 day of November, 19 57

My commission expires September 29, 1960

James S. Fisher
Notary Public.

PLUGGING
11-13-57 T. 24 R. 20E
BOOK PAGE 61 LINE 32

WELL LOG

Well: Dockendorf #1
 Location: C SE/4 NE/4
 Section 4-24S-20W
 Edwards County, Kansas
 Operator: D. E. Dunne, Jr.
 1005 Central Building
 Wichita, Kansas

Commenced: October 26, 1957
 Completed: November 12, 1957
 Contractor: Twin Drilling, Inc.
 1005 Central Building
 Wichita, Kansas

Casing Record:
 8-5/8" 223.58' W/200 Sacks Cement

Sand	160	Lime W/Shale Breaks	4132
Clay & Lime Shells	223	Lime	4217
Sand & Clay	280	Lime W/Shale breaks	4290
Shale	368	Chalk - Black Shale	4301
Shale & Shells	560	Lime	4555
Shale & Red Rock	895	Lime W/Shale Breaks	4585
Sand	975	(Mississippi 4644)	
Shale	1051	Lime & Shale	4652
Red Shale	1100	Chert & Lime	4662
Shells & Shale	1420	Chat	4680
Lime	1520	Chert & Lime	4706
Shale	1800	Lime	4751
Shale & Lime Shells	1905	(Kinderhook 4752)	
Shale & Lime	2400	Kinderhook Shale	4788
Lime	2600	(Sandstone 4782)	
Shale & Lime	2710	Lime	4795
Lime	2850	Shale & Sand	4818
Lime & Shale	2885	(Viola 4836)	
Lime	3800	Shale & Lime	4870 R.T.D.
Lime W/Shale Breaks	3922		
(Heebner 3976)		Dry Hole	
Lime	4001		
Lime & Shale	4071		
(Lansing 4082)			
Lime	4084		

STATE OF KANSAS)
) ss.
 COUNTY OF SEDGWICK)

The undersigned, TWIN DRILLING, INC., hereby certifies that the above log is a true and correct log of the formations encountered in drilling the above well as reflected by the Daily Drilling Report.

TWIN DRILLING, INC.

By Almeda Ray
 Secretary

Subscribed and sworn to before me
 this 19th day of November, 1957.

James S. Hickey
 Notary Public

My commission expires
 September 29, 1960

RECORDED
 NOV 21 1957
 TWIN DRILLING

PLUGGING
 FILE ... T. 24 R. 304
 BOOK PAGE 62 LINE 32