

STATE OF KANSAS
STATE CORPORATION COMMISSION


WELL PLUGGING RECORD

Give All Information Completely
Make Required Affidavit
Mail or Deliver Report to:
Conservation Division
State Corporation Commission
800 Bitting Building
Wichita, Kansas

OR
FORMATION PLUGGING RECORD

Strike out upper line
when reporting plugging
of formations.

Edwards County. Sec. 11 Twp 24S Rge 20W (E) (W)
Location as "NE 1/4 NW 1/4 SW 1/4" or footage from lines.
Lease Owner. The Texas Company
Lease Name. T. C. Crissman Well No. 1
Office Address. Wichita, Kansas
Character of Well (completed as Oil, Gas or Dry Hole) Dry Hole
Date well completed June 24 19 45
Application for plugging filed June 23 19 45
Application for plugging approved June 24 19 45
Plugging commenced June 24 19 45
Plugging completed June 24 19 45
Reason for abandonment of well or producing formation Dry Hole

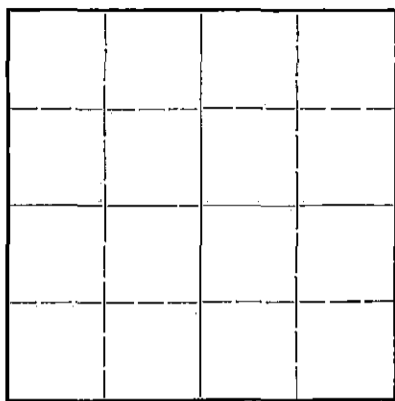

Locate well correctly on above
Section Plat

If a producing well is abandoned, date of last production 19...
Was permission obtained from the Conservation Division or its agents before plugging was commenced? Yes

Name of Conservation Agent who supervised plugging of this well H. W. Kerr, Great Bend, Kansas
Producing formation Depth to top Bottom Total Depth of Well 5128 Feet
Show depth and thickness of all water, oil and gas formations.

OIL, GAS OR WATER RECORDS


CASING RECORD

Formation	Content	From	To	Size	Put In	Pulled Out
				13-3/8"	149	None
				8-5/8"	2440	None

Describe in detail the manner in which the well was plugged, indicating where the mud fluid was placed and the method or methods used in introducing it into the hold. If cement or other plugs were used, state the character of same and depth placed, from feet to feet for each plug set.

Filled hole up with mud from bottom of hole up to 140' of top and set Bridge at 140', dumped in 20 sacks cement filled hole up to 86' of top and filled with mud up to 27' of top.
Set Bridge, dumped in 10 sacks cement to bottom of Cellar

PLUGGING
FILE REC-11-24R-20W
BOOK PAGE 17 LINE 41

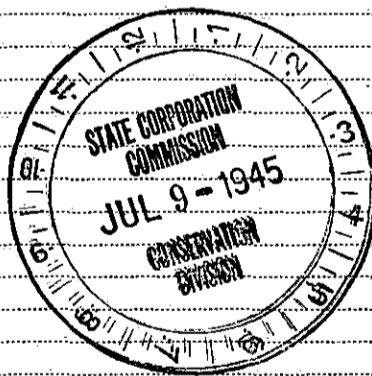

(If additional description is necessary, use BACK of this sheet)

Correspondence regarding this well should be addressed to The Texas Company, Production Department
Address Box 1801, Wichita, Kansas

STATE OF Kansas, COUNTY OF Sedgwick, ss.
M. C. Harrell (employee of owner) or (owner or operator) of the above-described well,
being first duly sworn on oath, says: That I have knowledge of the facts, statements, and matters herein contained and the log of the above-described well as filed and that the same are true and correct. So help me God.

(Signature) M. C. Harrell
Box 1801, Wichita, Kansas (Address)

SUBSCRIBED AND SWORN to before me this 9th day of July, 1945.

My commission expires August 26, 1945

Burshaw Butte Notary Public.