


STATE OF KANSAS  
STATE CORPORATION COMMISSION  
200 Colorado Derby Bldg.  
Wichita, Kansas 67202

Form CP-4  
Rev. 12-15-80

WELL PLUGGING RECORD

Give All Information Completely  
Make Required Affidavit

COUNTY Edwards SEC. 16 TWP. 24 RGE. 20  W  
Location as in quarters or footage from lines:  
C NE

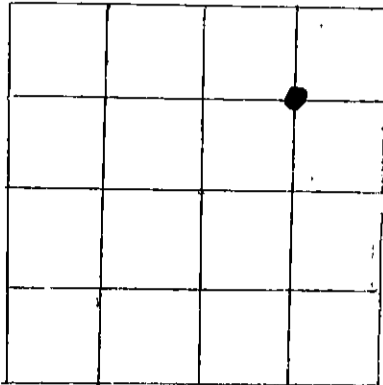

Locate Well  
correctly on above  
Section Platt.

Lease Owner Anador Resources, Inc.  
Lease Name Schinstock Well No. 2-16  
Office Address 5700 S. Quebec Suite 320 Englewood, Colorado 80111  
Character of Well (Completed as Oil, Gas or Dry Hole): Dry Hole  
Date Well Completed 10-1-81  
Application for plugging filed 12-1-81  
Plugging commenced 3-31-82  
Plugging completed 3-31-82  
Reason for abandonment of well or producing formation \_\_\_\_\_

Dry Hole

Was permission obtained from the Conservation Division or it's  
Agent's before plugging was commenced? Yes

Name of Conservation Agent who supervised plugging of this well Paul Luthi

Producing formation \_\_\_\_\_ Depth to top \_\_\_\_\_ bottom \_\_\_\_\_ T.D. 2625'

Show depth and thickness of all water, oil and gas formations.

OIL, GAS OR WATER RECORDS

Casing Record

Formation	Content	From	To	Size	Put in	Pulled Out
Krider	water	2460	2495	7"	451'	NONE
Winfield	water	2518	2542	4 1/2"	2623'	NONE
Towanda	water	2584	2614			

Describe in detail the manner in which the well was plugged, indicating where the mud fluid was placed and the method or methods used in introducing it into the hold. If cement or other plugs were used, state the character of same and depth placed, from \_\_\_\_\_ feet to \_\_\_\_\_ feet for each plug set.

Pumped 3 sxs. hulls, followed by 50 sxs. 50-50 poz, followed by 5 Bbls. mud, followed by 35 sxs. 50-50 poz, followed by 2 Bbls. mud, followed by one 4 1/2" rubber plug and 1 Bbl. mud. Squeezed w/1900 PSIG.  
Pumped 30 sxs. 50 -50 poz down annulus.

(If additional description is necessary, use BACK of this sheet)

Name of Plugging Contractor Sun Cementers

STATE OF Colorado COUNTY OF Arapahoe, ss.  
David S. Dudzik (employee of owner) or (owner or operator) of the above-described well, being first duly sworn on oath, says: That I have knowledge of the facts, statements, and matters herein contained and the log of the above-described well as filed and that the same are true and correct. So help me God.

(Signature) David S. Dudzik  
David S. Dudzik  
(Address)

5700 S. Quebec Suite 320

SUBSCRIBED AND SWORN TO before me this 13<sup>th</sup> day of April, 1982 Englewood, Colorado 80111

Constance A. Lawrence  
Constance A. Lawrence  
Notary Public  
STATE CORPORATION COMMISSION

My Commission expires: 02/25/84

APR 19 1982

CONSERVATION DIVISION  
Wichita, Kansas