


STATE OF KANSAS
STATE CORPORATION COMMISSION

WELL PLUGGING RECORD

Give All Information Completely
Make Required Affidavit
Mail or Deliver Report to
Conservation Division
State Corporation Comm.
245 North Water
Wichita, KS 67202

Edwards County. Sec. 26 Twp. 24 Rge. 17 E/W
Location as "NE/CNW $\frac{1}{4}$ /SW $\frac{1}{4}$ " or footage from lines
NW NW SW

Lease Owner Mustang Drilling & Exploration, Inc.
Lease Name Britton Well No. 1
Office Address Box 1425, Great Bend, Kansas 67530
Character of Well (Completed as Oil, Gas or Dry Hole)

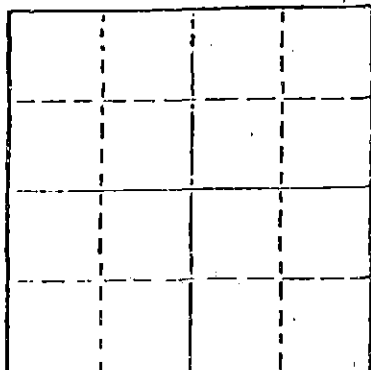

Locate well correctly on above
Section Plot

Dry Hole
Date Well completed Nov. 19 1980
Application for plugging filed 19
Application for plugging approved 19
Plugging commenced 19
Plugging completed Nov. 19 1980
Reason for abandonment of well or producing formation

D & A
If a producing well is abandoned, date of last production 19.

Was permission obtained from the Conservation Division or
its agents before plugging was commenced? yes

Name of Conservation Agent who supervised plugging of this well Duane Rankin
Producing formation Depth to top Bottom Total Depth of Well 4500
Show depth and thickness of all water, oil and gas formations.

OIL, GAS OR WATER RECORDS

CASING RECORD

FORMATION	CONTENT	FROM	TO	SIZE	PUT IN	PULLED OUT
				8 5/8"	346'	

Describe in detail the manner in which the well was plugged, indicating where the mud fluid
was placed and the method or methods used in introducing it into the hold. If cement or other
plugs were used, state the character of same and depth placed, from feet to
feet for each plug set.

Plugging with 50/50 Pozmix, 4% Gel, 3% cc.
50 sacks @ 720' 30 sacks @ 330' solid bridge plug @ 40' w/10 sacks
10 sacks in rat hole

(If additional description is necessary, use BACK of this sheet)
Name of Plugging Contractor Mustang Drilling, & Exploration, Inc.

STATE OF KANSAS COUNTY OF ~~KANSAS~~ BARTON
Milford Martin (employee of owner) owner or operator)

of the above-described well, being first duly sworn on oath, says: That I have knowledge of
the facts, statements, and matters herein contained and the log of the above-described well
as filed and that the same are true and correct. So help me God.

(Signature) Milford Martin
Box 1425, Great Bend, Kansas
(Address)

SUBSCRIBED AND SWORN TO before me this 21st day of Nov., 19 80

BEVERLY SHEWBART
Berton County, Kansas
My commission expires April 14, 1982

Beverly Shewbart
Notary Public.

STATE RECEIVED
CONSERVATION DIVISION
Wichita, Kansas
DEC - 1 1980

DRILLERS' WELL LOG

DATE COMMENCED: November 12, 1980
DATE COMPLETED: November 19, 1980

Mustang Drilling & Exploration, Inc.
"BRITTON # 1"
NW NW SW
Sec 26-T24-R17
Edwards County, Kansas
ELEVATION: 2112 K.B.

0 - 355'	Surface Clay, Sand
355 - 1144'	Red Bed, Shale
1144 - 1156'	Anhydrite
1156 - 2070'	Shale
2070 - 3388'	Shale, Lime
3358 - 3761'	Lime
3761 - 3765'	Shale
3765 - 3798'	Lime, Shale
3798 - 3890'	Shale
3890 - 3898'	Lime, Shale
3898 - 4353'	Lime, Shale
4353 - 4388'	Sand
4388 - 4422'	Lime, Shale, Chert
4422 - 4500'	Shale, Sand
4500'	RTD

FORMATION TOPS (Log)

Topeka	3358	-1246
Haebner	3761	-1649
Toronto	3780	-1668
Douglas	3798	-1686
Brown Lime	3890	-1778
Lawing	3898	-1786
Kansas City	4038	-1926
Base K.C.	4200	-2088
Cherokee	4353	-2241
Miss.	4388	-2276
Kinderhook Shale	4422	- 2310
Kinderhook Sand	4434	- 2322
Log TD	4500	-2388
RTD	4500	-2388

SURFACE PIPS:
Sat used 8 5/8", 24# pipe
at 246' w/275 sacks Common,
2% Gel, 3% cc.

AFFIDAVIT


STATE OF KANSAS)
COUNTY OF BARTON) ss.

I, Milford Martin, of Mustang Drilling & Exploration, Inc., doas state
the above to be true and correct to the best of his knowledge.

Milford Martin
Milford Martin

Subscribed and sworn to before me this 21st day of November, 1980.

Beverly Shewbart
Notary Public

	BEVERLY SHEWBART Barton County, Kansas My Appointment Expires <u>April 14, 1982</u>
---	---

My Appointment Expires

RECEIVED
DEC - 1 1980
CONSERVATION DIVISION
Wichita, Kansas