

15-095-30059-0000

RECEIVED JUN 14 1966 REGIST


Form CP-4

STATE OF KANSAS STATE CORPORATION COMMISSION

Give All Information Completely Make Required Affidavit Mail or Deliver Report to: Conservation Division State Corporation Commission 211 No. Broadway Wichita, Kansas

WELL PLUGGING RECORD

Kingman County, Sec. 17 Twp. 28 Rge. 5 W (W) Location as "NE/CNW/SW" or footage from lines SE-NW-NE Lease Owner D.R. Lauck Oil Co., Inc. Lease Name Pilgram Well No. 1 Office Address 301 So. Broadway Wichita, Kansas Character of Well (completed as Oil, Gas or Dry Hole) Dry Date well completed May 18 19 66 Application for plugging filed May 20 19 66 Application for plugging approved May 25 19 66 Plugging commenced June 4 19 66 Plugging completed June 8 19 66 Reason for abandonment of well or producing formation Non Productive

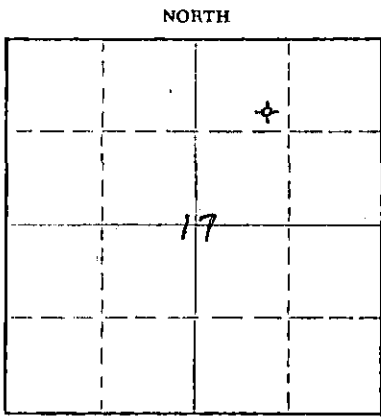

Locate well correctly on above Section Plat

If a producing well is abandoned, date of last production 19 Was permission obtained from the Conservation Division or its agents before plugging was commenced? Yes

Name of Conservation Agent who supervised plugging of this well Mr. Archie Elving Producing formation Mississippi Depth to top 3763 Bottom 3846 Total Depth of Well 3846 Feet Show depth and thickness of all water, oil and gas formations. PB 3810

OIL, GAS OR WATER RECORDS

CASING RECORD

Table with 7 columns: FORMATION, CONTENT, FROM, TO, SIZE, PUT IN, PULLED OUT. Row 1: Mississippi, Dry, 3763, 3846, 8 5/8, 216, None. Row 2: 5 1/2, 3846, 3196.

Describe in detail the manner in which the well was plugged, indicating where the mud fluid was placed and the method or methods used in introducing it into the hole. If cement or other plugs were used, state the character of same and depth placed, from feet to feet for each plug set.

PBTD 3810 Sand 3810- 3750 5 Sx Cement 3750- 3720 Mud 3720- 230 Rock Bridge 230- 220 25 Sx Cement 220- 145 Mud 145- 35 Rock & 10 Sx Cement 35 to base of cellar

RECEIVED STATE CORPORATION COMMISSION JUN 10 1966 CONSERVATION DIVISION WICHITA, KANSAS

(If additional description is necessary, use BACK of this sheet) Name of Plugging Contractor Glenn and Smith Pipe Pulling Co. Address Box 156, Ellinwood, Kansas

STATE OF KANSAS COUNTY OF SEDGWICK ss. H. E. Wolfe (employee of owner) or (owner or operator) of the above-described well, being first duly sworn on oath, says: That I have knowledge of the facts, statements, and matters herein contained and the log of the above-described well as filed and that the same are true and correct. So help me God.

(Signature) H. E. Wolfe Box 488, Ellinwood, Kansas (Address)

SUBSCRIBED AND SWORN TO before me this 14th day of June, 19 66

My commission expires March 12, 1967 Stella J. Lipps Notary Public.

15095-30059-0000

D. R. Lauck Oil Company, Inc.

Pilgram #1

SE NW NE Sec. 17-28S-5W
Kingman County, Kansas

Commenced: April 20, 1966

Completed: May 2, 1966

Casing Record: 216' 8-5/8" Cemented with 190 sacks Cement,
4 sacks Calcium Chloride.
3846' 5-1/2" Cemented with 105 sacks Salt
Saturated Cement.

Elevation: GL 1391; DF 1394; KB 1396.

Drillers Log

Tops

		Sample	Electra
Surface Sand	30		
Sand & Red Bed	140	Anhydrite	2335-939
Red Bed & Shale	218	Brown Lime	2945-1549 2948-1552
Blue Shale	240	Lansing	2977-1581 2978-1582
Shale & Shells	750	Base Kansas City	3418-2022 3420-2024
Anhydrite	780	Mississippian	3761-2365 3768-2372
Shale & Lime	1480	Total Depth	3846-2450 3847-2451
Brown Lime & Shale	1730		
Shale	2240		
Shale & Shells	2335	DST #1 (M) 3765-85, open 30 minutes, shut in	
Lime	2455	30 minutes, open 30 minutes, shut in	
Shale & Lime	2581	30 minutes. Gas to surface 7 minutes.	
Shale & Lime Streaks	2781	Gauged 109,000 cfg 10 minutes	
Shale, Sand & Lime		109,000 cfg 20 minutes	
Streaks	2980	109,000 cfg 30 minutes	
Lime	3058	Shut in 30 minutes.	
Lime & Shale	3145	Gauged 171,700 cfg 35 minutes	
Lime	3470	134,200 cfg 40 minutes	
Lime & Shale	3760	114,500 cfg 50 minutes	
Miss. Lime	3785	109,000 cfg 60 minutes	
Chert	3790	Recovered 75' drilling mud. ISIP	
Chert & Lime	3805	1113#, 30 minutes. FSIP 1035#, 30	
Chert	3846 RTD	minutes. IFP 45#. FFP 45#.	

DST #2 (M) 3785-3805, open 1 hour, weak blow decreasing to very weak blow and dead in 45 minutes. Recovered 30' mud. ISIP 22#, 30 minutes. FSIP 34#, 30 minutes. IFP 22#. FFP 22#.

RECEIVED
STATE CORPORATION COMMISSION
MAY 24 1966
CONSERVATION DIVISION
STATE OF KANSAS