


STATE OF KANSAS
STATE CORPORATION COMMISSION

WELL PLUGGING RECORD

Give All Information Completely
Make Required Affidavit
Mail or Deliver Report to
Conservation Division
State Corporation Comm.
245 North Water
Wichita, KS 67202

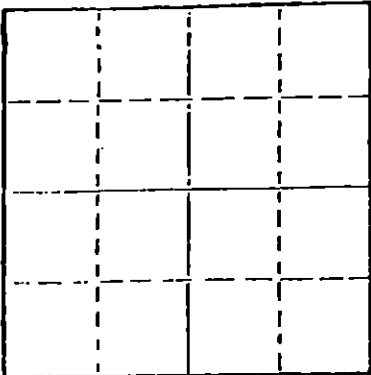

Locate well correctly on above
Section Plat

15-095-00167-0.0-01
Kingman County. Sec. 17 Twp. 28S Rge. 5W E/W
Location as "NE/CNW $\frac{1}{4}$ SW $\frac{1}{4}$ " or footage from lines
NW NW SE
Lease Owner Graves Drilling Company
Lease Name Broadway Well No. A-1
Office Address 910 Union Center, Wichita, Kansas 67202
Character of Well (Completed as Oil, Gas or Dry Hole)

Dry
Date Well completed June 8 1978
Application for plugging filed August 8 1978
Application for plugging approved August 9 1978
Plugging commenced September 25 1978
Plugging completed September 29 1978
Reason for abandonment of well or producing formation

Dry
If a producing well is abandoned, date of last production 19

Was permission obtained from the Conservation Division or
its agents before plugging was commenced? Yes

Name of Conservation Agent who supervised plugging of this well Bill Owens
Producing formation Depth to top Bottom Total Depth of Well 4398
Show depth and thickness of all water, oil and gas formations. 3877

OIL, GAS OR WATER RECORDS

CASING RECORD

FORMATION	CONTENT	FROM	TO	SIZE	PUT IN	PULLED OUT
				8 5/8	156	None
				4 1/2	3875	3488

Describe in detail the manner in which the well was plugged, indicating where the mud fluid was placed and the method or methods used in introducing it into the hold. If cement or other plugs were used, state the character of same and depth placed, from feet to feet for each plug set.

Pumped in 50 sacks cement
Pumped in 4 sacks hulls
25 sacks Jell
100 sacks 50-50 Pox 32 CC

(If additional description is necessary, use BACK of this sheet)

Name of Plugging Contractor Clarke Corporation

STATE OF Kansas COUNTY OF Barker, ss.
Elma Margueter (employee of owner) or (owner or operator)
of the above-described well, being first duly sworn on oath, says: That I have knowledge of the facts, statements, and matters herein contained and the log of the above-described well as filed and that the same are true and correct. So help me God.

(Signature) Elma Margueter
Medford, Mo. (Address)

SUBSCRIBED AND SWORN TO before me this 3rd day of October, 1978.

My commission expires April 4, 1982.

Jessie Thornton
STATE CORPORATION COMMISSION Public.

OCT 10 1978

CONSERVATION DIVISION
Wichita, Kansas