


Give All Information Completely  
Make Required Affidavit  
Mail or Deliver Report to:  
Conservation Division  
State Corporation Commission  
211 No. Broadway  
Wichita, Kansas

WELL PLUGGING RECORD

NORTH

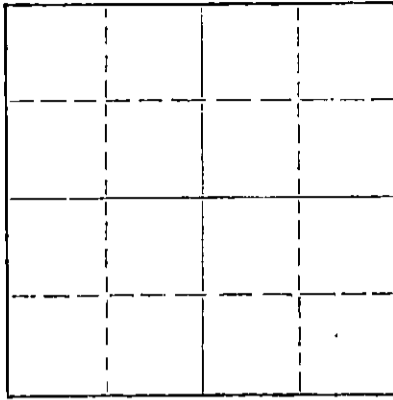

Locate well correctly on above Section Plat

Kingman County, Sec. 18 Twp. 28S Rge. (E) 5 (W)  
Location as "NE/CNW/SW" or footage from lines NW SW SE

Lease Owner Stelbar Oil Corporation, Inc.

Lease Name Delp Well No. 1

Office Address 310 Petroleum Bldg., Wichita 2, Kansas

Character of Well (completed as Oil, Gas or Dry Hole) oil and gas

Date well completed July 23, 1957

Application for plugging filed May 10, 1961

Application for plugging approved May 12, 1961

Plugging commenced May 12, 1961

Plugging completed May 13, 1961

Reason for abandonment of well or producing formation decreased production

If a producing well is abandoned, date of last production November, 1959

Was permission obtained from the Conservation Division or its agents before plugging was commenced? yes

Name of Conservation Agent who supervised plugging of this well Fred W. Hampel, Pretty Prairie, Kansas

Producing formation Mississippi Lime Depth to top 3834 Bottom 3930 Total Depth of Well 3839 Feet

Show depth and thickness of all water, oil and gas formations.

OIL, GAS OR WATER RECORDS

CASING RECORD

FORMATION	CONTENT	FROM	TO	SIZE	PUT IN	PULLED OUT
				8-5/8"	252'	
				5-1/2"	3930'	3113'

Describe in detail the manner in which the well was plugged, indicating where the mud fluid was placed and the method or methods used in introducing it into the hole. If cement or other plugs were used, state the character of same and depth placed, from \_\_\_\_\_ feet to \_\_\_\_\_ feet for each plug set.

Mudded from 3840' to 250', rock bridge at 250' to 240', run 20 sacks of cement from 240' to 180'. Mud from 180' to 35', rock and 10 sacks of cement to base of cellar.

RECEIVED  
STATE CORP. COMMISSION

MAY 20 1961 OS-26-601

CONSERVATION DIVISION  
Wichita, Kansas

(If additional description is necessary, use BACK of this sheet)

Name of Plugging Contractor Glenn & Smith Pipe Pulling Co.

Address Box 114, Ellinwood, Kansas

STATE OF Kansas, COUNTY OF Sedgwick, ss.

Bertrand M. Lester, Jr., (employee of owner) or (~~xxxxxxx~~) of the above-described well, being first duly sworn on oath, says: That I have knowledge of the facts, statements, and matters herein contained and the log of the above-described well as filed and that the same are true and correct. So help me God.

(Signature) \_\_\_\_\_

310 Petroleum Bldg., Wichita, Kansas  
(Address)

SUBSCRIBED AND SWORN to before me this 25th day of May, 1961

My commission expires January 18, 1964

Leona Hargrove

Notary Public.



15-09501739-0000

LOG

Delp No. 1  
NW SW SE  
Sec. 18-28S-5W  
Kingman County, Kansas

Owner: Stelbar Oil Corporation, Inc.  
Contractor: Prairie Oil & Gas Company, Inc.  
Drilling Commenced: 7-9-57  
Drilling Completed: 7-23-57

252' 8-5/8" cemented with 240 sacks  
3930' 5-1/2" cemented with 100 sacks

surface Clay and sand	0	45
lime, broken	45	60
lime	60	252
shale and shells	252	1344
shale and lime	1344	1440
shale and shells	1440	1622
shale and lime	1622	1844
shale and shells	1844	2408
shale and lime	2408	3035
Lansing-Kansas City	3035	3315
shale and lime	3315	3324
lime	3324	3746
lime and shale	3746	3834
Mississippi Lime	3834	3930 RTD

RECEIVED  
STATE CORPORATION COMMISSION  
MAY 26 1961  
CONSERVATION DIVISION  
Wichita, Kansas