


Give All Information Completely
Make Required Affidavit
Mail or Deliver Report to:
Conservation Division
State Corporation Commission
800 Biting Building
Wichita, Kansas

OR
FORMATION PLUGGING RECORD

Strike out upper line
when reporting plug-
ging off formations.

NORTH

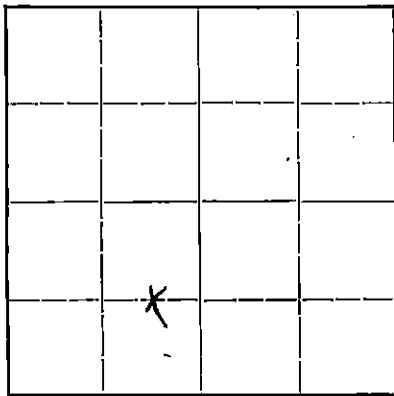

Locate well correctly on above
Section Plat

Kingman County. Sec. 29. Twp. 28. Rge. (E) 5 (W)
Location as "NE 1/4 NW 1/4 SW 1/4" or footage from lines SE 1/4 SW 1/4
Lease Owner Booth & Absher & Falcon-Seaboard
Lease Name Moorhouse Well No. I
Office Address 306 Union Natl. Bank Bldg. Wichita Ks.
Character of Well (completed as Oil, Gas or Dry Hole) Dry hole
Date well completed June 12 19 42
Application for plugging filed June 12 19 42
Application for plugging approved June 12 19 42
Plugging commenced June 12 19 42
Plugging completed June 12 19 42

Reason for abandonment of well or producing formation
If a producing well is abandoned, date of last production 19
Was permission obtained from the Conservation Division or its agents before plugging was com-
menced? Yes

Name of Conservation Agent who supervised plugging of this well RUEL DURKEE
Producing formation Depth to top Bottom Total Depth of Well 4332 Feet
Show depth and thickness of all water, oil and gas formations.

OIL, GAS OR WATER RECORDS

CASING RECORD

Formation	Content	From	To	Size	Put In	Pulled Out
Sand	water	60	75	10"	90	
Chat	Water	3900	3935			

Describe in detail the manner in which the well was plugged, indicating where the mud fluid was placed and the method or methods used in introducing it into the hole. If cement or other plugs were used, state the character of same and depth placed, from feet to feet for each plug set.

Hole was circulated each 500 ft. while laying down drill pipe with heavy mud. Wooden plug and 15 sacks cement set at 150 ft. Hole was filled to 15 ft. of cellar with mud and bridged and cemented with 6 sacks cement to bottom of cellar. Plate was welded on top of surface casing.

PD
6/17/42
29 28 5W
38 9

(If additional description is necessary, use BACK of this sheet)

Correspondence regarding this well should be addressed to Falcon-Seaboard Drlg. Co.
Address 306 Union Natl. Bank Bldg. Wichita Ks.

STATE OF Kansas, COUNTY OF Sedgwick, ss.
Edward M. Swearer (employee of owner) or (owner or operator) of the above-described well, being first duly sworn on oath, says: That I have knowledge of the facts, statements, and matters herein contained and the log of the above-described well as filed and that the same are true and correct. So help me God

(Signature) Edward M. Swearer
306 Union National Bldg., Wichita, Kansas
(Address)

SUBSCRIBED AND SWORN to before me this 22nd day of June, 19 42
Maxine Peebler
Notary Public.

My commission expires August 31, 1942

6-23-42

FALCON-SEABOARD DRILLING CO.
Moorehouse No. 1

1509500444000
SEC. 29 T. 28S R.5W
C E/2 SE SW

Total Depth 4332
Comm. 5-16-42 Comp. 6-12-42

Kingman County

Surface Pipe - 139' of 10" cemented with 200 sacks cement.

Figures Indicate Bottom of Formations

Shale	60
Sand	75
Shale and Shells	139
Blue Shale	430
Shale and Shells	735
Salt and Shale	900
Lime and Shale	935
Lime	1075
Shale and Lime	1085
Shale	1135
Lime	1175
Shale and Lime	1235
Lime	1280
Broken Lime	1395
Lime	1410
Sand	1423
Broken Lime	1460
Lime	1500
Shale and Shells	1515
Lime	1520
Lime and Shale	1690
Lime	1700
Sand	1720
Lime	1750
Shale and Shells	1998
Sand	2035
Shale and Shells	2170
Broken Lime	2270
Sand	2285
Shale and Shells	2332
Lime	2350
Shale and Shells	2370
Lime	2420
Shale	2485
Lime	2710
Shale and Lime	2742
Lime	2815
Shale and Lime	2825
Lime	2900
Broken Lime	2980
Shale	3055
Lime and Shale	3144
Lime	3174
Lime and Shale	3200
Broken Lime	3275
Shale	3322
Broken Lime	3348
Lime	3705
Lime and Shale	3748
Broken Lime	3785
Lime and Shale	3900
Chat	4003
Broken Lime	4045
Lime	4144
Shale	4160
Lime	4169
Shale and Shells	4260
Shale	4293
Lime	4317
Sand	4332
Total Depth.	

STATE OF KANSAS

COUNTY OF SEDGWICK

First, being duly sworn, Edward M. Swearer hereby states that the information contained herein is a true and correct log on the above described well.

FURTHER affiant saith not.

29 28 5W
38 9 Edward M. Swearer

SUBSCRIBED and sworn to before me
this 22nd day of June, 1942.

Marine Pender
Notary Public

My commission expires
August 31, 1942

