


Give All Information Completely
Make Required Affidavit
Mail or Deliver Report to:
Conservation Division
State Corporation Commission
211 No. Broadway
Wichita, Kansas

WELL PLUGGING RECORD 15-095-01323-0000

Kingman County. Sec. 29 Twp. 28s Rge. 5w (#E) W (W)

Location as "NE/CNWxSWx" or footage from lines N/2 SW SE
Lease Owner Petroleum, Inc.
Lease Name Moorhouse Well No. 4
Office Address Route 2, Great Bend, Kansas
Character of Well (completed as Oil, Gas or Dry Hole) Dry Hole
Date well completed December 29, 19 59
Application for plugging filed December 29, 19 59
Application for plugging approved December 29, 19 59
Plugging commenced December 29, 19 59
Plugging completed December 29, 19 59
Reason for abandonment of well or producing formation No producible zones

NORTH

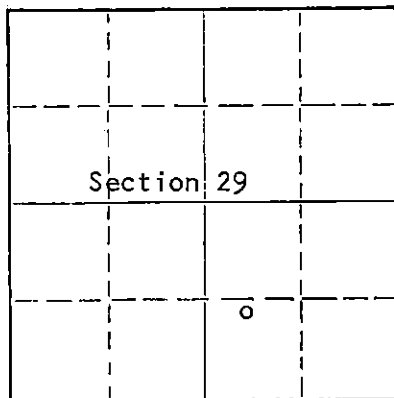

Locate well correctly on above
Section Plat

If a producing well is abandoned, date of last production None 19
Was permission obtained from the Conservation Division or its agents before plugging was commenced? Yes

Name of Conservation Agent who supervised plugging of this well Fred w. Hampel, Pretty Prairie, Kansas.
Producing formation ----- Depth to top ----- Bottom ----- Total Depth of Well 3960 Feet
Show depth and thickness of all water, oil and gas formations.

OIL, GAS OR WATER RECORDS

CASING RECORD

FORMATION	CONTENT	FROM	TO	SIZE	PUT IN	PULLED OUT
				8-5/8"	277'	None

Describe in detail the manner in which the well was plugged, indicating where the mud fluid was placed and the method or methods used in introducing it into the hole. If cement or other plugs were used, state the character of same and depth placed, from _____ feet to _____ feet for each plug set.

Mud up with heavy mud to 180' followed by 1/2 sacks hulls and a wooden plug.
Placed 15 sacks of cement through drill pipe on top of plug. Mud up to 35'
followed by 1/2 sack hulls and a wooden plug. Filled hole to base of well
cellar with 10 sacks of cement.

RECEIVED
STATE CORPORATION COMMISSION

SEP 28 1962
9-28-62
CONSERVATION DIVISION
Wichita, Kansas

(If additional description is necessary, use BACK of this sheet)

Name of Plugging Contractor Garvey Drilling Company
Address Route 2, Great Bend, Kansas

STATE OF Kansas, COUNTY OF Barton, ss.
Don Searle (employee of owner) or (XXXXXX) of the above-described

well, being first duly sworn on oath, says: That I have knowledge of the facts, statements, and matters herein contained and the log of the above-described well as filed and that the same are true and correct. So help me God.

(Signature) Don Searle
Route 2, Great Bend, Kansas
(Address)

SUBSCRIBED AND SWORN TO before me this 7th day of January, 19 60

My commission expires April 14, 1963

Arthur J. Niles
Notary Public.



WELL LOG

15-095-01323-0000

COMPANY **PETROLEUM, INCORPORATED**

SEC. 29 T. 28S R. 5W

FARM **MOORHOUSE** NO. 4


LOC. **N/2, SW, SE**

TOTAL DEPTH **3960'**

COUNTY **KINGMAN CO., KANSAS**

COMM. **December 17, 1959** COMP. **December 29, 1959**

CONTRACTOR **GARVEY DRILLING COMPANY**

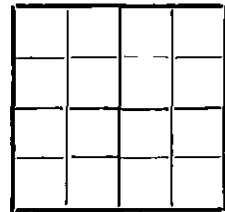

CASING **8 5/8" @ 277' w/200 sax.**

ELEVATION **1439' DF**

PRODUCTION **D & A**

FIGURES INDICATE BOTTOM OF FORMATIONS

75	Red rock & red clay
278	Red bed & shale
840	Shale & shells
860	Anhydrite
1070	Shale & shells
1310	Lime & shale
1480	Lime
2411	Lime & shale
2500	Shale
2868	Lime & shale
3380	Shale & lime
3765	Lime
3895	Lime & shale
3909	Lime
3919	Chert
3952	Chert & lime
3960	Lime
3960	T. D.

RECEIVED
STATE CORPORATION COMMISSION

SEP 28 1962

CONSERVATION DIVISION
Wichita, Kansas

State of KANSAS }
County of BARTON } ss:

I, VERNE A. MORRIS of GARVEY DRILLING COMPANY

upon oath state that the above and foregoing is a true and correct copy of the log of the #4 MOORHOUSE well.

Verne A. Morris

Subscribed and sworn to before me this 5th day of January 19 60

My Commission Expires: April 14, 1963

Arthur J. Mule
NOTARY PUBLIC