


15-095-00088-000

STATE OF KANSAS
STATE CORPORATION COMMISSION

WELL PLUGGING RECORD

Give All Information Completely
Make Required Affidavit
Mail or Deliver Report to:
Conservation Division
State Corporation Commission
800 Bitting Building
Wichita, Kansas

NORTH

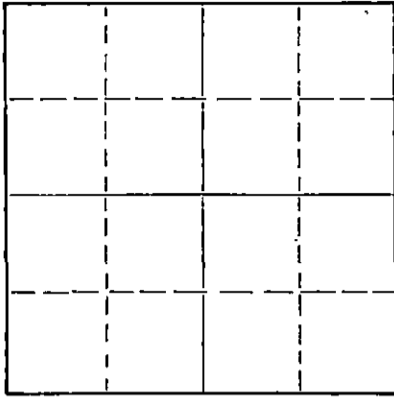

Locate well correctly on above
Section Plat

Kingman County. Sec. 11 Twp. 28 Rge. 5W (E) (W)
Location as "NE/CNW'SW" or footage from lines NW NW SE
Lease Owner Bennett & Roberts Drilling Co.
Lease Name Goldsborough Well No. 1
Office Address Russell, Ks.
Character of Well (completed as Oil, Gas or Dry Hole) Dry Hole
Date well completed 4/22 19 55
Application for plugging filed 4/22 verbally 19 55
Application for plugging approved 4/22 verbally 19 55
Plugging commenced 4/22 19 55
Plugging completed 4/22 19 55
Reason for abandonment of well or producing formation

If a producing well is abandoned, date of last production 19
Was permission obtained from the Conservation Division or its agents before plugging was commenced? Yes

Name of Conservation Agent who supervised plugging of this well Ruel Durkee
Producing formation Depth to top Bottom Total Depth of Well 3900 Feet
Show depth and thickness of all water, oil and gas formations.

OIL, GAS OR WATER RECORDS

CASING RECORD

FORMATION	CONTENT	FROM	TO	SIZE	PUT IN	PULLED OUT
				8 5/8"	144'	None

Describe in detail the manner in which the well was plugged, indicating where the mud fluid was placed and the method or methods used in introducing it into the hole. If cement or other plugs were used, state the character of same and depth placed, from feet to feet for each plug set.

Plug and rock bridge @ 135'. 15 sacks cement. Hole filled to 20' from top. Plug and 5 sacks cement.

APR 29 1955
CONSERVATION DIVISION
Wichita, Kansas

Name of Plugging Contractor
Address

STATE OF KANSAS, COUNTY OF RUSSELL, ss.
Harold Wurst (employee of owner) or (owner or operator) of the above-described well, being first duly sworn on oath, says: That I have knowledge of the facts, statements, and matters herein contained and the log of the above-described well as filed and that the same are true and correct. So help me God.

(Signature) Harold Wurst
Russell, Ks.
(Address)

SUBSCRIBED AND SWORN TO before me this 28th day of April, 19 55

Notary Public

My commission expires 6/17/58

PLUGGING
FILE SEC 11 T 28 R 5W
BOOK PAGE 114 LINE 24

15-095-0028000

Bennett & Roberts Drilling Co.
Goldsborough #1

NW NW SE Sec. 11-28-5W
Kingman County, Kansas

R.T.D. 3900'

Commenced 4/9/55
Completed 4/22/55

Tops	
Cimarron Anhydrite	630
Kansas City	3146
Mississippi Chert	3733
Mississippi Lime	3764

Contractor: Bennett & Roberts Drilling, Inc.

Casing Record
8 5/8" Set @ 144' w/120 sx cement

----- Figures Indicate Bottom of Formation -----

Sand & Red Bed	135'
Red Bed	144
Red Bed & Shale & Shells	475
Shale & Shells	630
Anhydrite	670
Lime, Shells & Shale	990
Lime & Shale	1665
Shale	2115
Lime & Shale	3074
Lime	3140
Lime & Shale	3270
Lime	3343
Lime & Shale	3588
Lime	3618
Lime & Shale	3690
Lime	3900

STATE OF KANSAS)
RUSSELL COUNTY) SS.

I hereby certify that the above information is correct to the best of my knowledge.

BENNETT & ROBERTS DRILLING, INC.

By John P. Durwin

Subscribed and sworn to before me this 28th day of April, 1955.

Clara Hummel
Notary Public

My Commission Expires 6/17/58

APR 29 1955
CONSERVATION DIVISION
Wichita, Kansas

PLUGGING
SEC 11-28-5W
PAGE 114 LINE 24