


WELL PLUGGING RECORD

Give All Information Completely
Make Required Affidavit
Mail or Deliver Report to:
Conservation Division
State Corporation Commission
800 Bittling Building
Wichita, Kansas

Kingman County, Sec. 11 Twp. 28s. Rge. (E) 5 (W)
Location as "NE/CNW $\frac{1}{4}$ SW $\frac{1}{4}$ " or footage from lines NW $\frac{1}{4}$ - NW $\frac{1}{4}$ - SW $\frac{1}{4}$
Lease Owner Champlin Refining Company
Lease Name Ruby S. Brown Well No. 1
Office Address P. O. Drawer #552, Enid, Oklahoma
Character of Well (completed as Oil, Gas or Dry Hole) Dry hole
Date well completed February 20 1953
Application for plugging filed February 20 1953
Application for plugging approved February 20 (Verball) 1953
Plugging commenced February 20 1953
Plugging completed February 20 1953
Reason for abandonment of well or producing formation

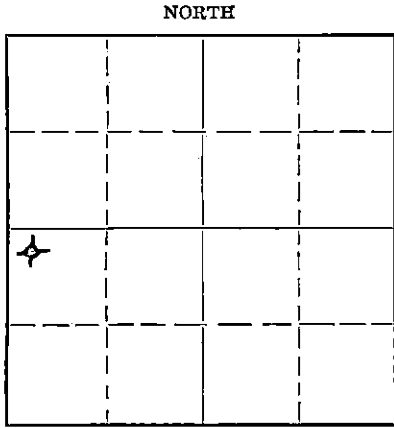

Locate well correctly on above Section Plat

If a producing well is abandoned, date of last production 19
Was permission obtained from the Conservation Division or its agents before plugging was commenced? Yes

Name of Conservation Agent who supervised plugging of this well Ruel Durkee
Producing formation Depth to top Bottom Total Depth of Well 3883 Feet
Show depth and thickness of all water, oil and gas formations.

OIL, GAS OR WATER RECORDS

CASING RECORD

Formation	Content	From	To	Size	Put In	Pulled Out
				8 5/8" OD	180'	None

Describe in detail the manner in which the well was plugged, indicating where the mud fluid was placed and the method or methods used in introducing it into the hole. If cement or other plugs were used, state the character of same and depth placed, from feet to feet for each plug set.

Filled hole with heavy rotary mud from 3883' T.D. to 150' and set Halliburton plug at 150' and pumped in 15 sacks of cement on top of plug then filled hole with heavy rotary mud from top of cement to 30' and set Halliburton plug and capped well with 10 sacks cement in top filling hole from 30' to bottom of cellar.

RECEIVED
STATE OF KANSAS
02-26-53

(If additional description is necessary, use BACK of this sheet)
Name of Plugging Contractor Ben E. Brack Oil Company (Rotary tools)
Address Great Bend, Kansas

STATE OF Kansas, COUNTY OF Barton, ss.
(employee of owner) or (owner or operator) of the above-described well,
being first duly sworn on oath, says: That I have knowledge of the facts, statements, and matters herein contained and the log of the above-described well as filed and that the same are true and correct. So help me God.

(Signature) S. W. Heer
P.O. Box 167, Ellinwood, Kansas
(Address)

SUBSCRIBED AND SWORN to before me this 25th day of February, 1953
Notary Public.

My commission expires Sept. 10, 1955
23-8390-s 6-51-20M

PLUGGING
FILE SEC 11 T 28 R 524
BOOK PAGE 21 LINE 21

15-095-01480-0500

CHAPLIN REFINING COMPANY

Ruby S. Brown #/
330' from the West Line
and 2310' from the South
Line of the Southwest
Quarter (SW/4) of Section
11-28s-5w, Kingman County
Kansas.

FORMATION LOG

0'-75'	Sand, Shale & Redbed
75'-105'	Sand & Redrock
105'-160'	Redrock & Shale
160'	T.D.
460'-715'	Shale & Shells
715'-850'	Shale & Lime
850'-990'	Lime & Shale
990'-1120'	Shale & Lime
1120'-1255'	Shale & Lime
1255'-1385'	Lime & Shale
1385'-1500'	Shale & Lime
1500'-1665'	Shale & Lime
1665'-1740'	Shale & Lime
1740'-1940'	Shale & Shells
1940'-1990'	Shale & Shells
1990'-2095'	Lime & Shale
2095'-2325'	Shale & Lime
2325'-2465'	Lime & Shale
2465'-2600'	Shale & Lime
2600'-2730'	Shale & Lime
2730'-2840'	Lime & Shale
2840'-2945'	Lime & Shale
2945'-3002'	Lime & Shale
3002'-3070'	Lime
3070'-3100'	Lime
3100'-3155'	Lime
3155'-3210'	Lime
3210'-3265'	Lime
3265'-3325'	Lime
3325'-3335'	Lime
3335'-3369'	Lime
3369'-3409'	Lime
3409'-3465'	Lime & Shale
3505'-3540'	Lime & Shale
3540'-3585'	Shale & Lime
3585'-3622'	Lime & Shale
3622'-3665'	Lime & Shale
3665'-3700'	Shale & Lime
3700'-3735'	Shale & Lime
3735'-3790'	Shale & Lime
3790'-3810'	Lime, chert & Shale
3810'-3815'	Lime, Chert & Shale
3815'-3835'	Lime & Chert
3835'-3839'	Lime & Chert
3839'-3870'	Lime & Chert
3870'-3884'	Lime & Chert
3883'	Total Depth

PLUGGING
 H&R SEC 11 T 28 R 52
 BOOK PAGE 81 LINE 21

NO. 101 ST. DIVISION
 Wichita, Kansas