


WELL PLUGGING RECORD

Give All Information Completely
Make Required Affidavit
Mail or Deliver Report to:
Conservation Division
State Corporation Commission
800 Bittling Building
Wichita, Kansas

NORTH

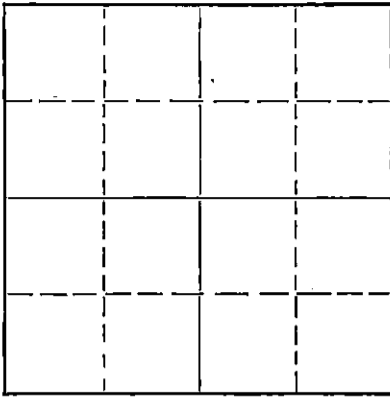

Locate well correctly on above
Section Plat

Kingman County. Sec. 15 Twp. 28S Rge. 5 (E) 5 (W)
Location as "NE/CNW $\frac{1}{4}$ SW $\frac{1}{4}$ " or footage from lines NW SE SW
Lease Owner Beardmore Drilling Company
Lease Name Foley Well No. 4
Office Address 603 Petroleum Building, Wichita 2, Kansas
Character of Well (completed as Oil, Gas or Dry Hole) Dry Hole
Date well completed April 16 19 52
Application for plugging filed April 16 19 52
Application for plugging approved April 16 19 52
Plugging commenced April 16 19 52
Plugging completed April 16 19 52
Reason for abandonment of well or producing formation Dry Hole

If a producing well is abandoned, date of last production _____ 19____
Was permission obtained from the Conservation Division or its agents before plugging was commenced? yes

Name of Conservation Agent who supervised plugging of this well Ruel Durkee, Box 597, McPherson, Kansas
Producing formation _____ Depth to top _____ Bottom _____ Total Depth of Well 3900 Feet
Show depth and thickness of all water, oil and gas formations.

OIL, GAS OR WATER RECORDS

CASING RECORD

Formation	Content	From	To	Size	Put In	Pulled Out
		0	122'	8-5/8	122'	None

Describe in detail the manner in which the well was plugged, indicating where the mud fluid was placed and the method or methods used in introducing it into the hole. If cement or other plugs were used, state the character of same and depth placed, from top feet to bottom feet for each plug set.

Mud to 160', set plug and dump 25 sacks cement, mud to 30', set plug and dump 5 sacs cement to complete.


(If additional description is necessary, use BACK of this sheet)
Name of Plugging Contractor Beardmore Drilling Company
Address 603 Petroleum Bldg., Wichita 2, Kansas

STATE OF Kansas COUNTY OF SEDGWICK, ss.
I, HEBER BEARDMORE, (employee of owner) or (owner or operator) of the above-described well, being first duly sworn on oath, says: That I have knowledge of the facts, statements, and matters herein contained and the log of the above-described well as filed and that the same are true and correct. So help me God.

(Signature) Heber Beardmore
603 Petroleum Bldg., Wichita 2, Kansas
(Address)

SUBSCRIBED AND SWORN TO before me this 21st day of April, 19 52

My commission expires January 28, 1956 Edward P. Tolle Notary Public.

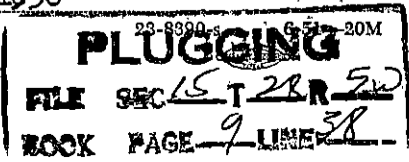

04-23-52

15-095-01483-0000

FOLEY No. 4

NW SE SW
Section 15-28S-5W
Kingman County, Kansas

Drilled for: Beardmore et al
Drilled by: Beardmore Drilling Company

Casing Record:

8-5/8" 122' w/82 Sacks Cement

Drilling Commenced: April 6, 1952
Drilling Completed: April 16, 1952

Elevation: 1395 DF
1393 GR

<u>FORMATION</u>	<u>DEPTH</u>
Sand Soil	25
Red Rock - Shale	121
Shale - Shells	1145
Lime Broken	1345
Shale - Shells	1645
Shale - Lime	2885
Lime - Shale	2975
Lime Broken	3095
Lime	3670
Shale - Lime	3775
Lime - Shale	3830
Lime Chert	3843
Lime	3855
Lime Chert	3900 T.D.

D & A

TOPS:

Lansing	3000
Mississippi	3796

DST #1 - 3810-3830 - Rec. 180' of gas cut mud, good blow 1 hour, shut in 15 minutes, 180# BHP.

DST #2 - 3830-3843 - Rec. 30' mud, Open 1 hour, shut in 15 minutes, BHP 340.

STATE OF KANSAS

SS

COUNTY OF SEDGWICK

I, the undersigned, being duly sworn on oath state that the above and within statement is a true and correct record and log of the well drilled on the location above-described, to the best of my knowledge and belief.

W. L. Beardmore

Subscribed and sworn to before me this 21st day of April, 1952.

Leonard P. Tolle
Notary Public

My Commission Expires: January 28, 1956

PLUGGING
 FILE SEC 15 T 28 R 50
 BOOK PAGE 9 LINE 38

APR 23 1952

NOTARY PUBLIC