

15-095-00204000


WELL PLUGGING RECORD

Give All Information Completely
Make Required Affidavit
Mail or Deliver Report to:
Conservation Division
State Corporation Commission
211 No. Broadway
Wichita, Kansas

Kingman County, Sec. 15 Twp. 28 Rge. 5 (E) W (W)

Location as "NE/CNW/SW" or footage from lines SW SW NW
Lease Owner Apex Supply Co.
Lease Name Foley #1 Well No.
Office Address Great Bend, Kansas
Character of Well (completed as Oil, Gas or Dry Hole)
Date well completed 19
Application for plugging filed 19
Application for plugging approved 19
Plugging commenced 6-15-59 19
Plugging completed 6-20-59 19
Reason for abandonment of well or producing formation

NORTH

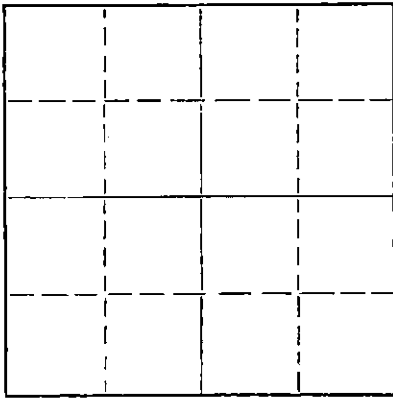

Locate well correctly on above
Section Plat

If a producing well is abandoned, date of last production 19
Was permission obtained from the Conservation Division or its agents before plugging was commenced? yes

Name of Conservation Agent who supervised plugging of this well Fred Hampel
Producing formation Depth to top Bottom Total Depth of Well 3822 Feet
Show depth and thickness of all water, oil and gas formations.

OIL, GAS OR WATER RECORDS

CASING RECORD

FORMATION	CONTENT	FROM	TO	SIZE	PUT IN	PULLED OUT
				8-5/8"	146'	none
				5-12/8"	3800'	3335'

Describe in detail the manner in which the well was plugged, indicating where the mud fluid was placed and the method or methods used in introducing it into the hole. If cement or other plugs were used, state the character of same and depth placed, from feet to feet for each plug set.

Checked the hole to 3822' and found it open.
Filled w/sand to 3775' and dumped 5 sacks of cement with bailer. Pulled 5 1/2" casing, cleared hole and mudded the hole from 330' to 140', set 10' rock bridge and dumped 20 sacks of cement. Mudded the hole to 35', set rock bridge and ran 10 sacks of cement to base of cellar.

PLUGGING COMPLETED

RECEIVED
STATE CORPORATION COMMISSION
JUL 29 1959
CONSERVATION DIVISION
Wichita, Kansas
07-29-59

(If additional description is necessary, use BACK of this sheet)

Name of Plugging Contractor Knight Casing Pulling Co.
Address Chase, Kansas

STATE OF KANSAS COUNTY OF RICE, ss.
I, Noel J. Knight (employee of owner) or (owner) of the above-described well, being first duly sworn on oath, says: That I have knowledge of the facts, statements, and matters herein contained and the log of the above-described well as filed and that the same are true and correct. So help me God.

(Signature) Noel Knight
Chase, Kansas (Address)

SUBSCRIBED AND SWORN to before me this 27th day of June, 19 59

Thomas V. Dreyer Notary Public.

My commission expires 9-27-62

PLUGGING
FILE SEC. 15 T. 28 R. 5 W
BOOK PAGE 46 LINE 6

WELL LOG BUREAU--KANSAS GEOLOGICAL SOCIETY
508 East Murdock, Wichita, Kansas


88786
15-095-00204-0000

Company- G. D. SMITHERMAN
Farm- Foley No. 1

SEC. 15 T. 28 R. 5W
SW SW NW

Total Depth. 3820 (Scout gave T.D. 3876 PB 3822)
Comm. 8-10-50 Comp. 8-23-50
Shot or Treated.
Contractor. Earl F. Wakefield
Issued. 10-20-56

County Kingman
KANSAS

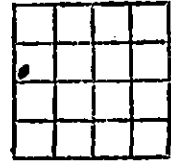

CASING:
8 5/8" 146' cem w/100 sx.
5 1/2" 3800' cem w/ 75 sx.

Elevation. 1402

Production. Pmp 1 BO

Figures Indicate Bottom of Formations.

clay, sand	35
shale, lime shells	146
lime, shale, shells	485
shale, shells, salt	700
lime shells, shale	980
lime, shale	1320
shale, shells	1380
lime, shale	1940
sand, shale	1955
lime, shale	2090
shale	2300
lime, shale	2775
shale sdy, lime	2840
shale, lime	3025
lime	3105
lime, shale	3272
lime	3390
shale, lime	3695
shale	3770
lime, shale	3808
lime	3820
Total Depth	3820

2 1/2

Tops:
Lansing 3013
Mississippi 3797
Dolomite 3818

RECEIVED
STATE CORPORATION COMMISSION

JUN 17 1959

CONSERVATION DIVISION
Wichita, Kansas

PLUGGING
FILE SEC. 15 T. 28 R. 5W
BOOK PAGE 46 LINE 6