


WELL PLUGGING RECORD

Give All Information Completely
Make Required Affidavit
Mail or Deliver Report to:
Conservation Division
State Corporation Commission
800 Bitting Building
Wichita, Kansas

NORTH

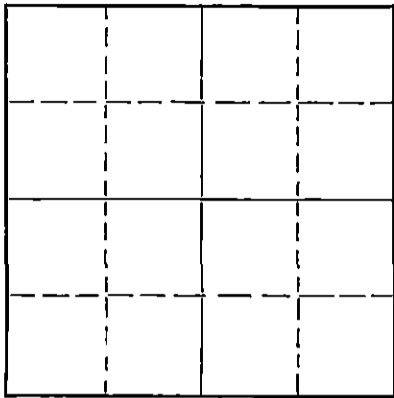

Locate well correctly on above
Section Plat

Kingman County. Sec. 16 Twp. 28 Rge. (E) 5 (W) 5
Location as "NE/CNW $\frac{1}{4}$ SW $\frac{1}{4}$ " or footage from lines SE SE NE
Lease Owner G. D. Smitherman
Lease Name Bolinger Well No. 1
Office Address 515 Piatt, Wichita, Kansas
Character of Well (completed as Oil, Gas or Dry Hole) Dry Hole
Date well completed September 19 19 50
Application for plugging filed September 20 19 50
Application for plugging approved September 20 19 50
Plugging commenced September 20 19 50
Plugging completed September 20 19 50
Reason for abandonment of well or producing formation Dry Hole
If a producing well is abandoned, date of last production None 19
Was permission obtained from the Conservation Division or its agents before plugging was commenced? Yes

Name of Conservation Agent who supervised plugging of this well
Producing formation ----- Depth to top ----- Bottom ----- Total Depth of Well 3890 Feet
Show depth and thickness of all water, oil and gas formations.

OIL, GAS OR WATER RECORDS

CASING RECORD

Formation	Content	From	To	Size	Put In	Pulled Out
				8 5/8"	137'	None

Describe in detail the manner in which the well was plugged, indicating where the mud fluid was placed and the method or methods used in introducing it into the hole. If cement or other plugs were used, state the character of same and depth placed, from ----- feet to ----- feet for each plug set.

Filled Hole to 140 feet with heavy mud.
Pushed wooden plug to 140 feet and cemented with 15 sacks. Filled hole with heavy mud to 35 feet, placed wooden plug at 35 feet and cemented with 10 sacks of cement to bottom of cellar.

RECEIVED
STATE CORPORATION COMMISSION
SEP 27 1950
CONSERVATION DIVISION
Wichita, Kansas

9-27-50

(If additional description is necessary, use BACK of this sheet)
Correspondence regarding this well should be addressed to Earl F. Wakefield
Address 307 Union National Bank
Wichita, Kansas

STATE OF Kansas, COUNTY OF Sedgwick, ss.

(employee of owner) or (owner or operator) of the above-described well, being first duly sworn on oath, says: That I have knowledge of the facts, statements, and matters herein contained and the log of the above-described well as filed and that the same are true and correct. So help me God.

(Signature) Earl F. Wakefield
307 Union National Bank, Wichita, Kansas
(Address)

SUBSCRIBED AND SWORN to before me this 23rd day of September, 1950.

My commission expires 12-23-50

Notary Public

PLUGGING
FILE SEC. 14 T. 28 R. 5W
BOOK PAGE 29 LINE 36

15-095-014850000

Bolinger #1
OWNER: G. D. Smitherman
CONTRACTOR: Earl F. Wakefield
COMM: 9-7-50 COMP: 9-19-50

SE SE NE 16-28-5W
Kingman County, Kansas
137' of 8 5/8" set @ 140'

Elevation: 1405 DF

Surface	140
Lime, Shells & Shale	170
Shale	310
Red Bed	315
Shale & Gravel	703
Lime & Shells	730
Lime & Shale	850
Shale & Lime	2015
Shale & Lime Streaks	2160
Shale & Lime	2550
Lime	2765
Lime & Shale	3240
Lime	3293
Lime & Shale	3788
Lime	3828
Lime & Chert	3890
T. D.	3890

STATE OF KANSAS)
) SS
COUNTY OF SEDGWICK)

I hereby certify that the above is a true and correct copy of the log of the Bolinger #1 well located SE SE NE 16-28-5W, Kingman County, Kansas.

Earl F. Wakefield

Subscribed and sworn to before me this 25 day of September, 1950.

Jeanne Robney

My Commission Expires: 12-23-50

RECEIVED
STATE CORPORATION COMMISSION
SEP 27 1950
CONSERVATION DIVISION
Wichita, Kansas

PLUGGING
FILE SEC 16-T-28-R-5W
BOOK PAGE 29 LINE 36