

15-095-01050-0000

STATE OF KANSAS
STATE CORPORATION COMMISSION


Form CP-4

Give All Information Completely
Make Required Affidavit
Mail or Deliver Report to:
Conservation Division
State Corporation Commission
211 No. Broadway
Wichita, Kansas

WELL PLUGGING RECORD

Kingman County. Sec. 16 Twp. 28 Rge. 5 (E) (W)
Location as "NE/CNW/SW" or footage from lines SE SW SW
Lease Owner Earl F. Wakefield
Lease Name Hobbs Well No. 2
Office Address 515 Union Center, Wichita, Kansas
Character of Well (completed as Oil, Gas or Dry Hole) oil
Date well completed 4-12 1951
Application for plugging filed 11-08 1963
Application for plugging approved 11-10 1963
Plugging commenced 11-14 1963
Plugging completed 11-15 1963
Reason for abandonment of well or producing formation depleted

NORTH

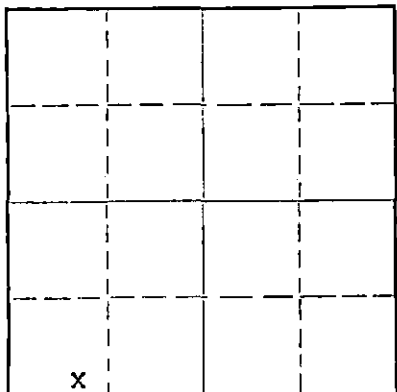

Locate well correctly on above
Section Plat

If a producing well is abandoned, date of last production 19
Was permission obtained from the Conservation Division or its agents before plugging was commenced? yes

Name of Conservation Agent who supervised plugging of this well Archie Elving
Producing formation _____ Depth to top _____ Bottom _____ Total Depth of Well 3859 Feet
Show depth and thickness of all water, oil and gas formations.

OIL, GAS OR WATER RECORDS

CASING RECORD

FORMATION	CONTENT	FROM	TO	SIZE	PUT IN	PULLED OUT
				8 5/8	129	circulated
				5 1/2	3853	3324.91

Describe in detail the manner in which the well was plugged, indicating where the mud fluid was placed and the method or methods used in introducing it into the hole. If cement or other plugs were used, state the character of same and depth placed, from _____ feet to _____ feet for each plug set.

Filled hole to 3830 feet and dumped 5 sacks cement.

Filled hole with mud to 225 feet, set 15 foot rock bridge and dumped 30 sacks cement.

Filled with mud to 40 feet, set 5 foot rock bridge and dumped 10 sacks cement.

RECEIVED
STATE CORPORATION COMMISSION

NOV 21 1963

CONSERVATION DIVISION
Wichita, Kansas

(If additional description is necessary, use BACK of this sheet)

Name of Plugging Contractor Flint Engineering & Construction Co.
Address Box 342, El Dorado, Kansas

STATE OF Kansas, COUNTY OF Butler, ss.

(employee of owner) or (owner or operator) of the above-described well, being first duly sworn on oath, says: That I have knowledge of the facts, statements, and matters herein contained and the log of the above-described well as filed and that the same are true and correct. So help me God.

(Signature) Mary Payne
El Dorado, Kansas
(Address)

SUBSCRIBED AND SWORN TO before me this 20th day of November, 1963

Ronald R. Hanson
Notary Public.

My commission expires Sept 27, 1967

15-095-01050000

Hobbs #2

Owner: Earl F. Wakefield
Contractor: Earl F. Wakefield
Comm: 4-1-51 Comp: 4-12-51

SE SW SW 16-28-5
Kingman County, Kansas
Casing: 129' of 8 5/8"
3853' of 5 1/2"

Elevation 1387

Surface	130
Shale & Shells	1050
Shale & Lime	1210
Lime & Shale	1660
Shale	1860
Shale & Lime	2315
Lime & Shale	3798
Lime & Chert	3856
Dolomite	3853
T. D.	3853

STATE OF KANSAS)
) SS.
COUNTY OF SEDGWICK)

I hereby certify that the above is a true and correct copy of the log of the Hobbs #2 well located SE SW SW 16-28-5, Kingman County, Kansas.

Earl F. Wakefield

Subscribed and sworn to before me this 25th day of April, 1951.

Ed. Jeanne Rafferty

My Commission Expires: 12-23-54