


STATE OF KANSAS  
STATE CORPORATION COMMISSION

WELL PLUGGING RECORD

Use All Information Completely  
Take Required Affidavit  
Mail or Deliver Report to  
Conservation Division  
State Corporation Comm.  
245 North Water  
Wichita, KS 67202

Kingman County, Sec. 10 Twp. 28S Rge. 7 E/W  
Location as "NE/CNW $\frac{1}{4}$ SW $\frac{1}{4}$ " or footage from lines  
NW/4 SW/4

Lease Owner Pate-Dombaugh Petroleum  
Lease Name Sparks Well No. 1  
Office Address 502 Union Center, Wichita, KS 67202  
Character of Well (Completed as Oil, Gas or Dry Hole)  
dry hole

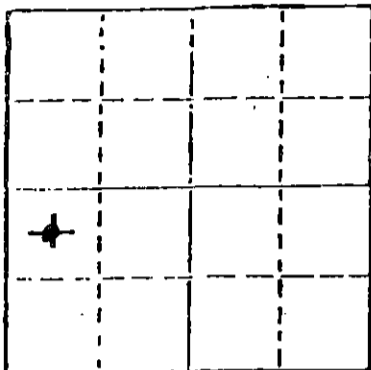

Locate well correctly on above  
Section Plat

Date Well completed 11/23 1981  
Application for plugging filed 11/23 1981  
Application for plugging approved 11/23 1981  
Plugging commenced 11/23 1981  
Plugging completed 11/23 1981

Reason for abandonment of well or producing formation  
No commercial quantity of oil or gas encountered.  
If a producing well is abandoned, date of last production  
19

Was permission obtained from the Conservation Division or  
its agents before plugging was commenced? yes

Name of Conservation Agent who supervised plugging of this well Mr. Lesli  
Producing formation Depth to top Bottom Total Depth of Well  
Show depth and thickness of all water, oil and gas formations.

OIL, GAS OR WATER RECORDS

CASING RECORD

FORMATION	CONTENT	FROM	TO	SIZE	PUT IN	PULLED OUT

Describe in detail the manner in which the well was plugged, indicating where the mud fluid  
was placed and the method or methods used in introducing it into the hold. If cement or other  
plugs were used, state the character of same and depth placed, from feet to  
feet for each plug set.

Total Depth 3960 feet. Set first plug at 500 feet with 60 sacks common  
cement, 2% Gel, 3% Calcium Chloride; second plug at 220 feet with 40 sacks,  
10 sacks and a bridge at 40 feet and 10 sacks in the rat hole. Cement by  
Allied Cementing. Job complete at 4:00 a.m. on November 23, 1981.

(If additional description is necessary, use BACK of this sheet)

Name of Plugging Contractor Kaw Drilling Co., Inc.

RECEIVED  
STATE CORPORATION COMMISSION

DEC - 1 1981

CONSERVATION DIVISION

STATE OF KANSAS COUNTY OF SEDGWICK

K. S. Martin, President of Kaw Drilling Co., Inc. ~~Company~~ ~~operator~~  
of the above-described well, being first duly sworn on oath, says: That I have knowledge of  
the facts, statements, and matters herein contained and the log of the above-described well  
as filed and that the same are true and correct. So help me God.


(Signature)

*K. S. Martin*  
K. S. Martin, President 1010 Union Center  
(Address) Wichita, KS 67202

SUBSCRIBED AND SWORN TO before me this 25th day of November, 1981.

My commission expires December 10, 1983

*Mary Susan Whaley*  
Mary Susan Whaley Notary Public.

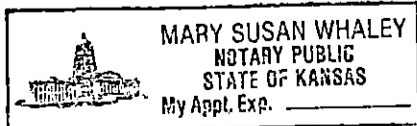

15-095-211900000

OPERATOR:  
CONTRACTOR:  
WELL NAME:  
LOCATION:  
SPUD DATE:  
COMPLETION DATE:

Pate-Dombaugh Petroleum  
Kaw Drilling Co., Inc.  
Sparks #1  
NW/4 SW/4 Sec. 10-28S-7W  
Kingman County, Kansas  
November 16, 1981  
November 23, 1981

0 2616  
2616 3108  
3108 3295  
3295 3950  
3950 3960  
3960 3960


Shale  
Shale and Lime  
Lime  
Shale and Lime  
Lime  
R.T.D.

Spud hole at 6:00 p.m. on November 16, 1981. Drilled 217 feet of 12 1/4 inch hole. Ran 5 joints of 8 5/8 inch, 24 pound new surface casing. (Tallied at 202.71 feet.) Set at 217 feet with 200 sacks common cement, 2% calcium chloride and 3% gel. Cement by Allied Cementing. Plug down at 11:45 p.m. on November 16, 1981.

Total Depth 3960 feet. Set first plug at 500 feet with 60 sacks common cement, 2% gel and 3% calcium chloride; second plug at 220 feet with 40 sacks, 10 sacks and a bridge at 40 feet and 10 sacks in the rat hole. Cement by Allied Cementing. Job complete at 4:00 a.m. on November 23, 1981.

STATE OF KANSAS )  
 ) ss  
COUNTY OF SEDGWICK )


I, K. S. Martin, President of Kaw Drilling Co., Inc., being first duly sworn and upon my oath, state that: I have knowledge of the facts, statements and matters herein contained and the log of the above described well as filed and that the same are true and correct. So help me God.

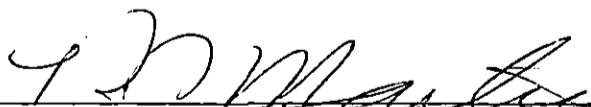  
K. S. Martin, President

SUBSCRIBED AND SWORN to before me on this 25th day of November, 1981.

RECEIVED  
STATE CORPORATION COMMISSION  
DEC - 1 1981  
CONSERVATION DIVISION  
Wichita, Kansas

My Commission Expires:  
December 10, 1983

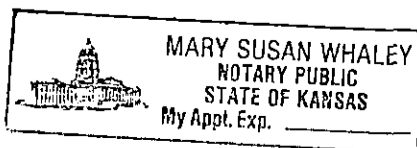  
MARY SUSAN WHALEY  
NOTARY PUBLIC  
STATE OF KANSAS  
My Appt. Exp. \_\_\_\_\_