

15-095-00369-0000

STATE OF KANSAS
STATE CORPORATION COMMISSION

Give All Information Completely
Make Required Affidavit
Mail or Deliver Report to:
Conservation Division
State Corporation Commission
211 No. Broadway
Wichita, Kansas

WELL PLUGGING RECORD

Kingman County. Sec. 12 Twp. 28 Rge. 7 (E) (W) X

Location as "NE/CNWxSWx" or footage from lines. C NE NE NW/4

Lease Owner Virginia Drlg Co Inc.

Lease Name Greenleaf Well No. 1

Office Address 712 Brown Bldg-Wichita 2, Kansas

Character of Well (completed as Oil, Gas or Dry Hole) DH

Date well completed 6-14-59 19

Application for plugging filed 6-14-59 19

Application for plugging approved 6-14-59 19


Plugging commenced 6-14-59 19

Plugging completed 6-14-59 19

Reason for abandonment of well or producing formation

If a producing well is abandoned, date of last production 19

Was permission obtained from the Conservation Division or its agents before plugging was commenced? yes

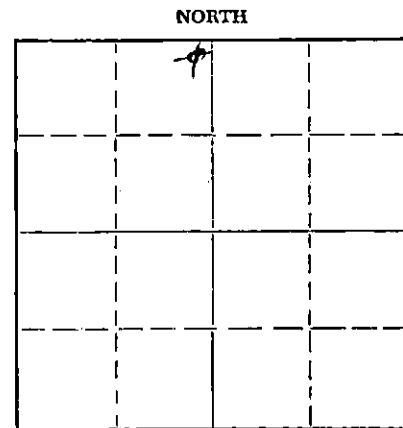

Locate well correctly on above Section Plat

Name of Conservation Agent who supervised plugging of this well

Producing formation Depth to top Bottom Total Depth of Well 4276 Feet

Show depth and thickness of all water, oil and gas formations.

OIL, GAS OR WATER RECORDS

CASING RECORD

FORMATION	CONTENT	FROM	TO	SIZE	PUT IN	PULLED OUT
		0	178	8 5/8"	181	None

Describe in detail the manner in which the well was plugged, indicating where the mud fluid was placed and the method or methods used in introducing it into the hole. If cement or other plugs were used, state the character of same and depth placed, from feet to feet for each plug set.

Mudded to 170 ft - set plug w/20 sx cem 1/2 sx hulls

" " 35 ft - set plug w/ 10 sx cem. 1/2 sx hulls

RECEIVED
STATE CORPORATION COMMISSION
JUN 27 1959
6-23-59
CONSERVATION DIVISION
Wichita, Kansas

(If additional description is necessary, use BACK of this sheet)

Name of Plugging Contractor Virginia Drlg Co Inc.

Address 712 Brown Bldg-Wichita 2, Kansas

STATE OF Kansas, COUNTY OF Sedgwick, ss.

S. A. Murphy (employee of owner) or (owner or operator) of the above-described well, being first duly sworn on oath, says: That I have knowledge of the facts, statements, and matters herein contained and the log of the above-described well as filed and that the same are true and correct. So help me God.

(Signature) S. A. Murphy

712 Brown Bldg.-Wichita 2, Kansas (Address)

SUBSCRIBED AND SWORN TO before me this 15th day of June 1959

Mable Zastrow Notary Public.

My commission expires Febr. 5, 1961

PLUGGING
FILE SEC. 12 T. 28. R. 7W
BOOK PAGE 59 LINE 38

15-095-00369-0000

GREENLEAF #1 - C NE NE NW/4 Sec. 12-28-7 Kingman County, Kansas
Company - Virginia Drilling Co Inc.
Commenced - May 27, 1959
Completed - June 14, 1959
Elevation - 1478 KB
Total Depth - 4276

8 5/8" set at 178 ft w/140 sz cem. 200# cc

FORMATION

DEPTH

Sand-clay	0- 125
Shale-shells	125- 178
Redbed - shale	178- 450
Redbed - shale - shells	450- 920
Anhydrite	920- 970
Lime-shale	970-2900
Sand-shale-lime	2900-3110
Lime-shale	3110-3167
Lime	3167-3630
Lime-shale	3630-3875
Cherty-lime	3875-4033
Lime	4033-4085
Cherty lime	4085-4120
Shale-lime	4120-4230
Lime-shale-sand	4230-4276 TD

TOPS:

2849 - Heebner
2864 - Toronto
3102 - KC
3583 - Base KC
3853 - Mississippi
4116 - Kinderhook
4224 - Misener
4225 - Viola
4249 - Simpson
4260 - Simpson sand

S. A. Murphy

S. A. Murphy

Subscribed and sworn to before me, a Notary Public,
this 15th day of June, 1959.

Walter Hartman

Notary Public

My commission expires: Febr. 5, 1961.

RECEIVED
STATE CORPORATION COMMISSION
JUN 23 1959
CONV.
Wichita, Kansas

PLUGGING
FILE SEC. 12 T. 28 R. 2w
BOOK PAGE 59 LINE 38