


STATE OF KANSAS
STATE CORPORATION COMMISSION

WELL PLUGGING RECORD

Give All Information Completely
Make Required Affidavit
Mail or Deliver Report to:
Conservation Division
State Corporation Commission
800 Blitt Building
Wichita, Kansas

OR
~~FORMATION PLUGGING RECORD~~ Strike out upper line when reporting plugging off formations.

NORTH

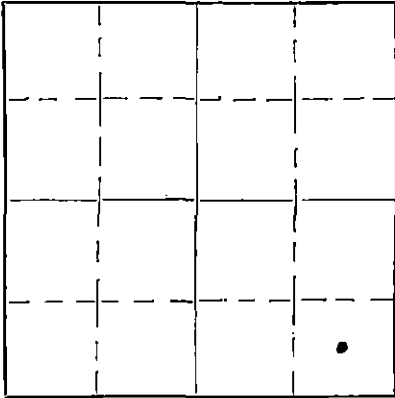

Locate well correctly on above Section Flat

Reno County. Sec. 26 Twp. 23S Rge. 4 (E) 4 (W)
Location as "NE 1/4 NW 1/4 SW 1/4" or footage from lines. SE 1/4, 660' fm Sth & East lines
Lease Owner **Sinclair Prairie Oil Co**
Lease Name **Adam T. Base** Well No. **3**
Office Address **Box 521, Tulsa, Okla.**
Character of Well (completed as Oil, Gas or Dry Hole) **oil well**
Date, well completed **April 25, 1934** 193
Application for plugging filed **Dec. 9, 1939** 193
Application for plugging approved **Dec. 11, 1939** 193
Plugging Commenced **Feb. 15, 1940** 193
Plugging Completed **Feb. 26, 1940** 193
Reason for abandonment of well or producing formation **well has ceased producing**

If a producing well is abandoned, date of last production **Oct. 1939** 193
Was permission obtained from the Conservation Division or its agents before plugging was commenced? **Yes**

Name of Conservation Agent who supervised plugging of this well **Ruel Durkee**
Producing formation _____ Depth to top _____ Bottom _____ Total Depth of Well _____ Feet
Show depth and thickness of all water, oil and gas formations.

OIL, GAS OR WATER RECORDS


CASING RECORD

| Formation | Content | From | To | Size | Put In | Pulled Out |
|-----------|---------|------|------|--------|--------|------------|
| Chat | dry | 3248 | 3347 | 15-1/2 | 255' | 0 |
| | | | | 12-1/2 | 474' | 0 |
| | | | | 8-5/8 | 3329' | 2583 |

Describe in detail the manner in which the well was plugged, indicating where the mud fluid was placed and the method or methods used in introducing it into the hole. If cement or other plugs were used, state the character of same and depth placed, from _____ feet to _____ feet for each plug set.

Heavy Rotary Mud 3347' to 3317'
Cement 3317' to 3282' (Six Sacks)
Heavy Rotary Mud 3282' to 391'
Cement Plug 391' to 370' (20 Sacks)
Mud 370' to 5'
Cement 5' to (Bottom of Cellar)

FILE 26 23 4th
BOOK PAGE 87 LINE 11

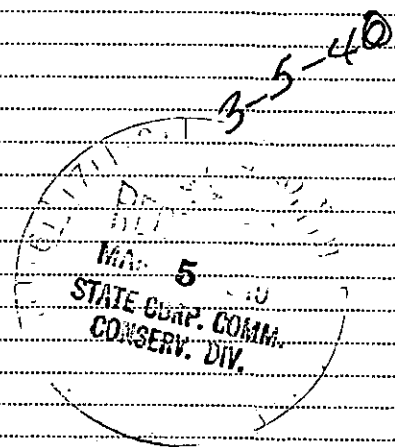

(If additional description is necessary, use BACK of this sheet)

Correspondence regarding this well should be addressed to **Mr. J.E. Millar**
Address **1319-1/2 Main, Great Bend, Kans**

STATE OF Kansas COUNTY OF Barton, ss.
John E. Millar (employee of owner) or (owner or operator) of the above-described well,

being first duly sworn on oath, says: That I have knowledge of the facts, statements, and matters herein contained and the log of the above-described well as filed and that the same are true and correct. So help me God.

(Signature) John E. Millar

(Address) _____

SUBSCRIBED AND SWORN to before me this 4th day of March, 1940

My commission expires 6-14-43

J. MacFarlane
Notary Public.

WELL LOG

15-155-82670-0000

Lease: - Adam T. Base Well # 3.
 660' f/south line & 660' f/east Line
 SE/4 of sec. 26-23-4W.
 Reno County, Kansas.

| <u>Formation</u> | <u>Thickness of Strata.</u> | <u>Total Depth</u> |
|-----------------------|-----------------------------|--------------------|
| Sand | 115 | 115' |
| Clay, Shells & Shale | 93 | 208' |
| Sandstone | 38 | 246' |
| Shale | 9 | 255' |
| Shale | 226 | 481' |
| Shale & Lime Shells | 286 | 767' |
| Lime | 30 | 797' |
| Lime & Shale | 45 | 842' |
| Shale & Shells | 173 | 1015' |
| Shale | 85 | 1100' |
| Shale & Shells | 273 | 1373' |
| Red Bed | 9 | 1382' |
| Shale | 100 | 1482' |
| Shale & Shells | 573 | 2055' |
| Lime | 20 | 2075' |
| Shale | 17 | 2092' |
| Shale | 30 | 2122' |
| Shale & Shells | 120 | 2242' |
| Shale | 67 | 2309' |
| Sand & Shale | 70 | 2379' |
| Shale | 37 | 2416' |
| Lime | 33 | 2449' |
| Shale & Lime Shells | 58 | 2507' |
| Shale - Sticky | 67 | 2574' |
| Shale & Shells | 85 | 2659' |
| Shale | 20 | 2679' |
| Broken | 27 | 2706' |
| Broken Lime & Shale | 20 | 2726' |
| Lime & Shale | 81 | 2807' |
| Lime | 44 | 2851' |
| Lime | 55 | 2906' |
| Broken Lime | 27 | 2933' |
| Lime | 31 | 2964' |
| Hard Lime | 25 | 2989' |
| Lime | 14 | 3003' |
| Hard Lime | 18 | 3021' |
| Shale & Lime | 93 | 3114' |
| Shale | 74 | 3188' |
| Steel Line correction | | 3182' |
| Sticky Shale | 15 | 3197' |
| Shale - Variagated | 43 | 3240' |
| Shale | 16 | 3256' |
| Lime | 2 | 3258' |
| Hard Chat | 4 | 3262' |
| Soft Chat | 13 | 3275' |
| Hard Chat | 18 | 3293' |
| Chat | 72 | 3365' |
| Hard Chat | 2 | 3367' T. D. |

2-12-38 to 3-14-38 Plugged back from 3367' to 3347' with Rock & Lead wool.

This well Plugged and Abandoned as of 2-26-40.

FILE # 26-23-4W
 BOOK PAGE 87 LINE 11

ADAM T. BASE
 WELL # 3
 15-155-82670-0000

ADAM T. BASE
 WELL # 3
 15-155-82670-0000