

STATE OF KANSAS
STATE CORPORATION COMMISSION


WELL PLUGGING RECORD

Give All Information Completely
Make Required Affidavit
Mail or Deliver Report to:
Conservation Division
State Corporation Commission
800 Blitting Building
Wichita, Kansas

~~FORMATION PLUGGING RECORD~~

Strike out upper line
when reporting plug-
ging off formations.

NORTH

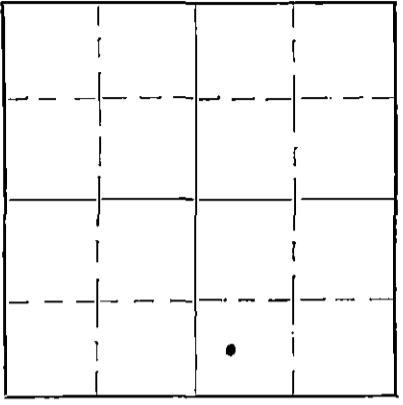

Locate well correctly on above
Section Plat

Reno County. Sec. 26 Twp. 23S Rge. (E) 4 (W)

Location as "NE 1/4 NW 1/4 SW 1/4" or footage from lines. SE 1/4 - 860' fm Sth & 570' fm West lines

Lease Owner Sinclair Prairie Oil Co

Lease Name Adam T. Base Well No. 5

Office Address Box 521, Tulsa, Okla.

Character of Well (completed as Oil, Gas or Dry Hole) Oil well

Date, well completed Aug. 11 1934

Application for plugging filed Dec. 9 1939

Application for plugging approved Dec. 11 1939

Plugging Commenced Feb. 1 1934

Plugging Completed Feb. 13 1934

Reason for abandonment of well or producing formation dry

If a producing well is abandoned, date of last production Oct. 31 1939

Was permission obtained from the Conservation Division or its agents before plugging was commenced? Yes

Name of Conservation Agent who supervised plugging of this well Ruel Durkee

Producing formation Chat Depth to top 3229 Bottom 3362 Total Depth of Well 3362 Feet

Show depth and thickness of all water, oil and gas formations.

OIL, GAS OR WATER RECORDS


CASING RECORD

Formation	Content	From	To	Size	Put In	Pulled Out
Chat	Oil & Water	3229	3362	15-1/2	249	none
				8-5/8	3228	2439

Describe in detail the manner in which the well was plugged, indicating where the mud fluid was placed and the method or methods used in introducing it into the hole. If cement or other plugs were used, state the character of same and depth placed, from _____ feet to _____ feet for each plug set.

- 3362 - 3208 dumped mud
- 3208 - 240 " " & 6 sx cmt
- 240 - 235 rock bridge
- 235 - 215 20 sx cmt
- 215 - to btm of cellar, mud
- 8 sx cmt capon top of surface pipe

26 23 4W
87-LINE-12

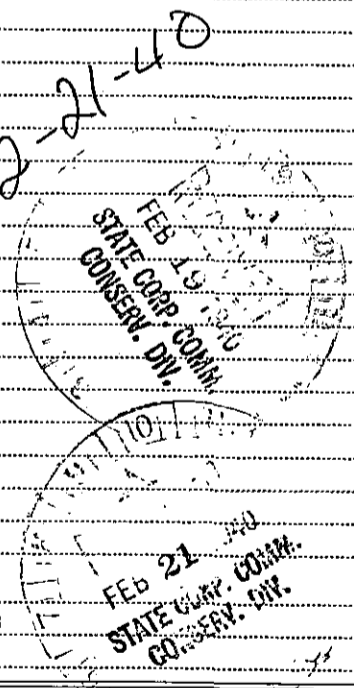

(If additional description is necessary, use BACK of this sheet)
Correspondence regarding this well should be addressed to Mr J.E. Millar, Supt.
Address 1319 Main, Great Bend, Kans

STATE OF _____, COUNTY OF _____, ss.

_____ (employee of owner) or (owner or operator) of the above-described well, being first duly sworn on oath, says: That I have knowledge of the facts, statements, and matters herein contained and the log of the above-described well as filed and that the same are true and correct. So help me God.

(Signature) J. E. Millar
(Address)

SUBSCRIBED AND SWORN to before me this 17th day of February, 1943

My commission expires 6-14-43
Notary Public.

WELL LOG

Lease:- Adam T. Base Well # 5
 600' f/south line & 570' f/west line
 SE/4 of sec. 26-23S-4W
 Reno County, Kansas.

15-155-02672-0600

<u>Formation</u>	<u>Thickness of Strata</u>	<u>Total Depth</u>
Surface	113	113'
Sand	139	252'
Shale	4	256'
Sand & Shale	288	544'
Shale, Broken Lime & Lime Shells.	109	653'
Shale & Shells	267	920'
Shale & Lime	397	1317'
Shale & Shells	235	1552'
Broken Lime	72	1624'
Lime & Shale	405	2029'
Lime	41	2070'
Shale	28	2098'
Lime	60	2158'
Lime & Shale	50	2208'
Shale	40	2248'
Lime	139	2387'
Sticky Shale	16	2403'
Kansas City Lime	42	2445'
Broken Lime	21	2466'
Shale	51	2517'
Kansas City Lime	22	2539'
Lime	32	2571'
Shale & Lime	25	2596'
Shale	39	2635'
Shale & Lime	10	2645'
Lime	460	3105'
Lime & Shale	29	3134'
Shale	95	3229'
Chat	143	3372' T.D.

3-16-38 to 4-18-38 Plugged back from 3372' to 3362' with Rock & Lead wool.

This well plugged and abandoned as of the 2-13-40

26 23 4W
 87 APR 12