


STATE OF KANSAS  
STATE CORPORATION COMMISSION  
Give All Information Completely  
Make Required Affidavit  
Mail or Deliver Report to:  
Conservation Division  
State Corporation Commission  
212 No. Market  
Wichita, Kansas

WELL PLUGGING RECORD

Kingman County, Sec. 1 Twp. 27S Rge. 8 (E) (W)  
Location as "NE/CNW/SW" or footage from lines SE SE SW

Lease Owner H.C. Bennett  
Lease Name Lucy Stucky Well No. 1  
Office Address 1214 Union Nat'l Bldg. Wichita, Kansas  
Character of Well (completed as Oil, Gas or Dry Hole) oil well  
Date well completed 12-21-58 19  
Application for plugging filed 8-1-67 19  
Application for plugging approved 8-3-67 19  
Plugging commenced 8-8-67 19  
Plugging completed 8-12-67 19  
Reason for abandonment of well or producing formation

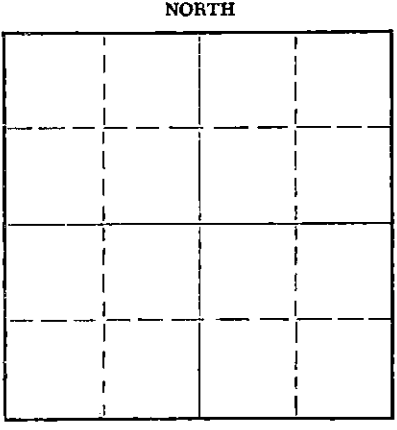

Locate well correctly on above Section Plat

If a producing well is abandoned, date of last production 19  
Was permission obtained from the Conservation Division or its agents before plugging was commenced? yes

Name of Conservation Agent who supervised plugging of this well Archie Elving  
Producing formation Depth to top Bottom Total Depth of Well 4334 Feet  
Show depth and thickness of all water, oil and gas formations.

OIL, GAS OR WATER RECORDS

CASING RECORD

FORMATION	CONTENT	FROM	TO	SIZE	PUT IN	PULLED OUT
				8 5/8	264.77	none
				5 1/2	3710	3221.24

Describe in detail the manner in which the well was plugged, indicating where the mud fluid was placed and the method or methods used in introducing it into the hole. If cement or other plugs were used, state the character of same and depth placed, from feet to feet for each plug set.

Fill to 3400' with sand and dump 5 sacks, mud hole from 400' to 260' and set 10' rock bridge from 260' to 250', dump 25 sacks cement, mud to 40', set 10' rock bridge and 10 sacks cement to surface

RECEIVED  
CORPORATION COMMISSION  
AUG 24 1967  
CONSERVATION DIVISION  
WICHITA, KANSAS

(If additional description is necessary, use BACK of this sheet)  
Name of Plugging Contractor Flint Engineering and Const. Co.  
Address 2375 W. Central El Dorado, Kansas

STATE OF Kansas, COUNTY OF Butler, ss.  
(employee of owner) or (owner or operator) of the above-described well, being first duly sworn on oath, says: That I have knowledge of the facts, statements, and matters herein contained and the log of the above-described well as filed and that the same are true and correct. So help me God.

(Signature) James Davis

SUBSCRIBED AND SWORN TO before me this 21 day of August (Address) 67, 19

Ronald R. Hanson

My commission expires Sept. 27, 1967

Notary Public.

# WELL LOG

15-095-00354-0001

COMPANY **SUNRAY-MID-CONTINENT OIL COMPANY**

SEC. **1** T. **27S** R. **8W**

FARM **LUCY STUCKY** NO. **1**

LOC. **SE, SE, NW**

TOTAL DEPTH **4334'**

COUNTY **KINGMAN CO., KANSAS**

COMM. **December 8, 1958** COMP. **December 21, 1958**

CONTRACTOR **GARVEY DRILLING COMPANY**



CASING **8 5/8" @ 264.77' W/275 sax.**  
**5 1/2" @ 3710' W/100 sax.**

ELEVATION **1998' DF**

PRODUCTION

FIGURES INDICATE BOTTOM OF FORMATIONS

**RECEIVED**  
STATE CORPORATION COMMISSION

**AUG 3 1967**

CONSERVATION DIVISION  
Wichita, Kansas

15	Surface sand
45	Red bed
270	Red bed & shale
670	Red bed
1210	Shale & shells
1625	Lime & shale
2580	Shale & lime
3095	Lime & shale
3240	Shale & lime
3350	Lime & shale
3665	Lime
3743	Lime & shale
3920	Lime
3958	Lime & shale
4050	Chert & lime
4086	Lime
4158	Lime & shale
4208	Shale & lime
4282	Shale
4329	Viola Lime
4334	Sand
4334	T. D.

State of KANSAS }  
County of BARTON } ss:

I, VERNE A. MORRIS of GARVEY DRILLING COMPANY

upon oath state that the above and foregoing is a true and correct copy of the log of the #1 LUCY STUCKY well

Subscribed and sworn to before me this 23rd day of December 19 58

My Commission Expires: November 12, 1962

Verne A. Morris  
Notary Public