


STATE OF KANSAS
STATE CORPORATION COMMISSION

15-095-21143-0000

WELL PLUGGING RECORD

Give All Information Completely
Make Required Affidavit
Mail or Deliver Report to
Conservation Division
State Corporation Comm.
245 North Water
Wichita, KS 67202

Kingman County, Sec. 7 Twp. 27S Rge. 9W E/W
Location as "NE/CNW $\frac{1}{4}$ /SW $\frac{1}{4}$ " or footage from lines
C NW NW SE
Lease Owner Patton Oil Company
Lease Name Bradshaw Well No. #2A
Office Address 5660 S. Syracuse Circle-#200, Englewood, Co.
Character of Well (Completed as Oil, Gas or Dry Hole) Dry Hole

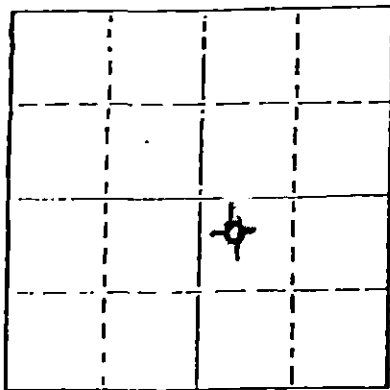

Locate well correctly on above
Section Plot

Date Well completed October 17, 1981
Application for plugging filed October 17, 1981
Application for plugging approved October 17, 1981
Plugging commenced October 17, 1981
Plugging completed October 17, 1981
Reason for abandonment of well or producing formation Dry Hole

If a producing well is abandoned, date of last production N/A 19

Was permission obtained from the Conservation Division or its agents before plugging was commenced? Yes

Name of Conservation Agent who supervised plugging of this well Murice V. Leslie
Producing formation _____ Depth to top _____ Bottom _____ Total Depth of Well 4340'
Show depth and thickness of all water, oil and gas formations.

OIL, GAS OR WATER RECORDS

CASING RECORD

FORMATION	CONTENT	FROM	TO	SIZE	PUT IN	PULLED OUT
Sand				8 5/8"	241'	none

Describe in detail the manner in which the well was plugged, indicating where the mud fluid was placed and the method or methods used in introducing it into the hold. If cement or other plugs were used, state the character of same and depth placed, from _____ feet to _____ feet for each plug set.

540' 50 SX
240' 40 SX
40' 10 SX
RH 10 SX

50 - 50 PAZ 2% 3%

(If additional description is necessary, use BACK of this sheet)

Name of Plugging Contractor _____ Service Company _____


STATE OF Kansas COUNTY OF Sedgwick, ss.
Paul A. Seymour, Jr. (employee of owner) or (owner or operator)
of the above-described well, being first duly sworn on oath, says: That I have knowledge of the facts, statements, and matters herein contained and the log of the above-described well as filed and that the same are true and correct. So help me God.

(Signature) Paul A. Seymour, Jr.
Paul A. Seymour, Jr. Box 8287-Munger Station
(Address) Wichita, Kansas 67208

SUBSCRIBED AND SWORN TO before me this 20th day of October, 1981

commission expires August 18, 1984

LaDonna F. Landrum
LaDonna F. Landrum
Notary Public.

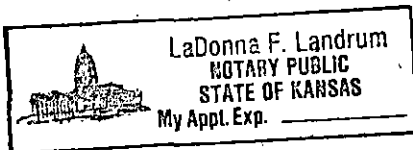

RECEIVED
STATE CORPORATION COMMISSION

OCT 21 1981

CONSERVATION DIVISION
Wichita, Kansas

15-095-21143-0000

BIG SPRINGS DRILLING, INC.

P.O. BOX 8287
MUNGER STATION
WICHITA, KANSAS 67208

SUITE 29 • 400 NORTH WOODLAWN • (316) 681-1732

October 20, 1981

DRILLERS LOG

Re: Bradshaw #2A
C NW NW SE
Sec. 7 Twp 27S Rg 9W
Kingman County, Kansas

OPERATOR: Patton Oil Company
CONTRACTOR: Big Springs Drilling, Inc.
COMMENCED: October 6, 1981
COMPLETED: October 17, 1981

SURFACE PIPE: 241' of 8 5/8" w/200 SX Commom 2% gel 3% cc1

0	244'	Sand & Red Bed
244'	1617'	Shale
1617'	3758'	Lime & Shale
3758'	3859'	Lime
3859'	4110'	Lime & Shale
4110'	4193'	Lime
4193'	4340'	Lime & Shale
4340'		RTD

We certify that the above and foregoing is a true and correct copy of the log on the Bradshaw #2A located in Kingman County, Kansas.

Big Springs Drilling, Inc.

Paul A. Seymour Jr.
 Paul A. Seymour Jr. STATE CORPORATION COMMISSIONER
 RECEIVED
 OCT 21 1981

Subscribed and sworn to before me this 20th day of October, 1981.

LaDonna F. Landrum
 LaDonna F. Landrum Notary Public
 CONSERVATION DIVISION
 Wichita, Kansas

My Commission Expires:

August 18, 1984

