

15-095-20794-0000


STATE OF KANSAS  
STATE CORPORATION COMMISSION

WELL PLUGGING RECORD

Give All Information Completely  
Make Required Affidavit  
Mail or Deliver Report to  
Conservation Division  
State Corporation Comm.  
245 North Water  
Wichita, KS 67202

Kingman County, Sec. 23 Twp. 27s Rge. 10W E/W  
Location as "NE/CNW/SW" or footage from lines  
C NE NW

Lease Owner Patton Oil Company  
Lease Name Richardson Well No. 1  
Office Address Suite 200, 5660 So. Syracuse Cr., Englewood,  
Character of Well (Completed as Oil, Gas or Dry Hole) Colo.

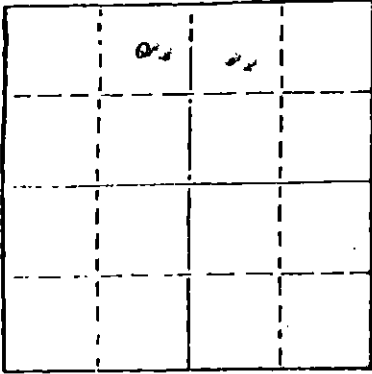

Locate well correctly on above  
Section Plot

Dry Hole  
Date Well completed 3-29-79 19  
Application for plugging filed 3-29-79 19  
Application for plugging approved 3-29-79 19  
Plugging commenced 3-29-79 19  
Plugging completed 3-29-79 19

Reason for abandonment of well or producing formation  
Dry Hole

If a producing well is abandoned, date of last production  
N/A 19

Was permission obtained from the Conservation Division or  
its agents before plugging was commenced? yes

Name of Conservation Agent who supervised plugging of this well W. T. Owens  
Producing formation \_\_\_\_\_ Depth to top \_\_\_\_\_ Bottom \_\_\_\_\_ Total Depth of Well 2395  
Show depth and thickness of all water, oil and gas formations.

OIL, GAS OR WATER RECORDS

CASING RECORD

FORMATION	CONTENT	FROM	TO	SIZE	PUT IN	PULLED OUT
Sand				8 5/8"	218'	None

Describe in detail the manner in which the well was plugged, indicating where the mud fluid  
was placed and the method or methods used in introducing it into the hold. If cement or other  
plugs were used, state the character of same and depth placed, from \_\_\_\_\_ feet to  
\_\_\_\_\_ feet for each plug set.

40 sx 210'  
12 sx 40'  
3 sx RH

RECEIVED  
STATE CORPORATION COMMISSION  
APR 10 1979  
CONSERVATION DIVISION  
Wichita, Kansas

(If additional description is necessary, use BACK of this State  
Name of Plugging Contractor Service Company

STATE OF Kansas COUNTY OF Sedgwick, ss.  
Paul A. Seymour, Jr. (employee of owner) or (owner or operator)  
of the above-described well, being first duly sworn on oath, says: That I have knowledge of  
the facts, statements, and matters herein contained and the log of the above-described well  
as filed and that the same are true and correct. So help me God.

(Signature) Paul A. Seymour, Jr.  
Box 8287, Munger Station, Wichita, KS 67208  
(Address)

SUBSCRIBED AND SWORN TO before me this 9th day of April, 1979

My commission expires May 30, 1979

Ruth M. Bassett  
Ruth M. Bassett Notary Public.

15095-20794-000

# BIG SPRINGS DRILLING, INC.

P.O. BOX 8287  
MUNGER STATION  
WICHITA, KANSAS 67208

SUITE 29 • 400 NORTH WOODLAWN • (316) 681-1732

April 9, 1979

## DRILLERS LOG

Re: Richardson No. 1  
C NE NW  
Sec. 23 - Twp 27s- Rq 10W  
Kingman County, Kansas

OPERATOR: Patton Oil Company  
CONTRACTOR: Big Springs Drilling, Inc.  
COMMENCED: 3-24-79  
COMPLETED: 3-29-79

RECEIVED  
STATE CORPORATION COMMISSION

APR 10 1979

CONSERVATION DIVISION  
Wichita, Kansas

Surface Pipe: 218' of 8 5/8" w/175 sx Common 2% gel 3% cci


0	218	Sand and Redbeds
218	1325	Shale and Redbeds
1325	1540	Lime and Shale
1540	1830	Lime
1830	2319	Lime and Shale
2319	2395	Lime
2395		RTD

We certify that the above and foregoing is a true and correct copy of the log on the # 1 Richardson located in Kingman County, Kansas.

BIG SPRINGS DRILLING, INC.

  
Paul A. Seymour, Jr.

Subscribed and sworn to before me this 9th day of April, 1979.

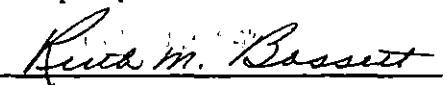  
Ruth M. Bassett Notary Public

My Commission Expires:

May 30, 1979

WICHITA COUNTY RECORDS  
APR 10 1979