

WELL PLUGGING RECORD

Give All Information Completely  
Make Required Affidavit  
Mail or Deliver Report to:  
Conservation Division  
State Corporation Commission  
800 Bittling Building  
Wichita, Kansas

Kingman

County. Sec. 24 Twp. 27 Rge. (E) 10 (W)

Location as "NE/CNW $\frac{1}{4}$ SW $\frac{1}{4}$ " or footage from lines Ctr. NW $\frac{1}{4}$  NW $\frac{1}{4}$  NE $\frac{1}{4}$

Lease Owner Lion Oil Company

Lease Name Smalley Well No. 1

Office Address P. O. Box 639, Pratt, Kansas

Character of Well (completed as Oil, Gas or Dry Hole) Dry Hole

Date well completed 8-7 19 51

Application for plugging filed 12-19 19 51

Application for plugging approved 12-19 19 51


Plugging commenced 12-19 19 51

Plugging completed 12-23 19 51

Reason for abandonment of well or producing formation Dry Hole

If a producing well is abandoned, date of last production 19

Was permission obtained from the Conservation Division or its agents before plugging was commenced? Yes

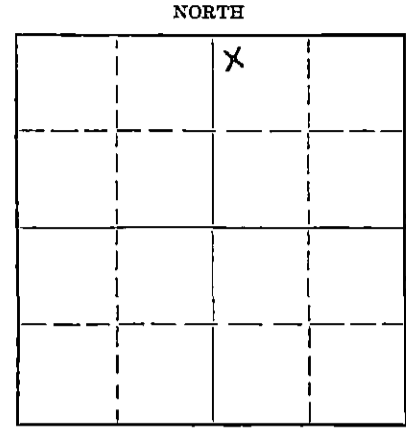

Locate well correctly on above Section Plat

Name of Conservation Agent who supervised plugging of this well Ruell Durkee

Producing formation Depth to top Bottom Total Depth of Well 4277 Feet

Show depth and thickness of all water, oil and gas formations. Plugged Back TD 3595 Feet

OIL, GAS OR WATER RECORDS

CASING RECORD

Formation	Content	From	To	Size	Put In	Pulled Out
				9 5/8"	292'	None
				5 1/2"	4267'	3075'

Describe in detail the manner in which the well was plugged, indicating where the mud fluid was placed and the method or methods used in introducing it into the hole. If cement or other plugs were used, state the character of same and depth placed, from feet to feet for each plug set.

Rocked hole from 3595' to 3560' and ran 6 sacks of cement. Mudded hole to 285'. Set 10' rock bridge and ran 20 sacks of cement at 275'. Mudded hole to 15' and ran 5 sacks of cement. Plugging completed.

(If additional description is necessary, use BACK of this sheet)

Name of Plugging Contractor West Supply Company

Address Co. Chase, Kansas 01-02-52

STATE OF Kansas, COUNTY OF Pratt, ss.

Vernon Hayes (employee of owner) or (owner/operator) of the above-described well,

being first duly sworn on oath, says: That I have knowledge of the facts, statements, and matters herein contained and the log of the above-described well as filed and that the same are true and correct. So help me God.

(Signature) Vernon Hayes


P. O. Box 639, Pratt, Kansas (Address)

SUBSCRIBED AND SWORN to before me this 29<sup>th</sup> day of December, 1951.

Van Nambek

Notary Public.

My commission expires August 29, 1955

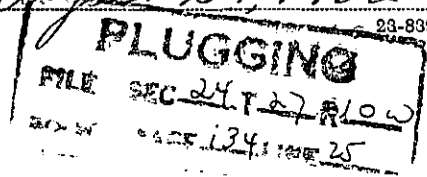

15-095-00207-000

SMALLEY WELL NO. 1

NW NW NE  
SEC. 24-27-10  
KINGMAN COUNTY,  
KANSAS

CONTRACTOR: THE R. W. RINE DRILLING COMPANY  
STARTED: JUNE 7, 1951

FINISHED: JUNE 20, 1951

LOG

SAND AND CLAY	0	-	295	9-5/8" Csg. @ 290' W/250 Sx.
RED BED AND SHALE	295	-	650	Syfo @ 500' - O.K.
SALT AND SHALE	650	-	1375	Syfo @ 1000' - O.K.
LIME AND SHALE	1375	-	1565	Syfo @ 1500' - O.K.
LIME AND SHALE	1565	-	1945	
SHALE AND SHELLS	1945	-	2308	Syfo @ 2000' - 1/2"
SHALE	2308	-	2586	Syfo @ 2500' - O.K.
LIME AND SHALE	2586	-	3045	
LIME AND SHALE	3045	-	3200	Syfo @ 3000' - O.K.
LIME AND SHALE	3200	-	3290	
LIME	3290	-	3500	
LIME	3500	-	3700	Syfo @ 3500' - O.K.
LIME	3700	-	3825	
LIME	3825	-	3900	
LIME AND SHALE	3900	-	3992	
LIME AND CHERT	3992	-	4037	
CHERT AND SHALE	4037	-	4060	
SHALE	4060	-	4170	
SHALE	4170	-	4230	
SHALE, CHERY LIME	4230	-	4273	5-1/2" Csg. @ 4274' W/200 Sx.
LIME	4273	-	4275	

STATE OF KANSAS }  
COUNTY OF SEDGWICK } ss.

I, R. M. GREEN, DO HEREBY CERTIFY THAT THE ABOVE IS A TRUE AND ACCURATE LOG OF THE SMALLEY WELL NO. 1, LOCATED NW NW NE OF SECTION 24-27-10, KINGMAN COUNTY, KANSAS.

*R. M. Green*  
ASSISTANT SECRETARY

SUBSCRIBED TO AND SWORN BEFORE ME THIS 26TH DAY OF JUNE, 1951.

*Louisa V. Pederson*  
NOTARY PUBLIC

MY COMMISSION EXPIRES APRIL 20, 1955.

NOTARY PUBLIC  
JAN - 21 1952  
COMMISSION

PLUGGING  
MIX SEC 24 T 27 R 10W  
BOOK PAGE 124 LINE 25