

COPY

SIDE ONE

CONFIDENTIAL

7/3/89

STATE CORPORATION COMMISSION OF KANSAS  
OIL & GAS CONSERVATION DIVISION  
WELL COMPLETION OR RECOMPLETION FORM  
ACO-1 WELL HISTORY  
DESCRIPTION OF WELL AND LEASE

Operator: License # 5118  
Name TGT Petroleum Corp.  
Address 209 E. William #165  
City/State/Zip Wichita, Ks. 67202

Purchaser: Clear Creek, Inc.  
McPherson, Ks.

Operator Contact Person B. Lynn Herrington  
Phone 262-6489

Contractor: License # 5422  
Name Abercrombie Drilling, Inc.

Wellsite Geologist Al Sude  
Phone 943-4361

Designate Type of Completion  
 New Well  Re-Entry  Workover  
 Oil  Gas  Dry  
 SWD  Inj  Other (Core, Water Supply etc.)  
If OWWO: old well info as follows:

Operator  
Well Name  
Comp. Date Old Total Depth

WELL HISTORY

Drilling Method:  
 Mud Rotary  Air Rotary  Cable  
3-15-89 3-25-89 5-12-89  
Spud Date Date Reached TD Completion Date  
4530' 4505'  
Total Depth PBD

Amount of Surface Pipe Set and Cemented at 416 feet  
Multiple Stage Cementing Collar Used? Yes  No  
If yes, show depth set feet  
If alternate 2 completion, cement circulated from feet depth to w/ SX cmt  
Cement Company Name  
Invoice #

API NO. 15-047-21.333-0000  
County Edwards  
C. W/2 W/2 SE Sec 3 Twp 24S Rge 18 East X West


1320 Ft North from Southeast Corner of Section  
2310 Ft West from Southeast Corner of Section  
(Note: Locate well in section plat below)

Lease Name Britton Trust "A" Well # 2

Field Name Nettelton

Producing Formation Lansing/KC

Elevation: Ground 2143 KB 2155

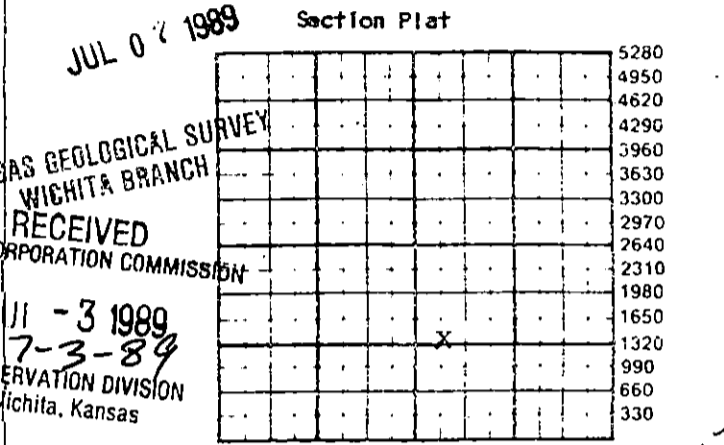

WATER SUPPLY INFORMATION  
Disposition of Produced Water:  Disposal  Repressuring  
Docket #

Questions on this portion of the ACO-1 call:  
Water Resources Board (913) 296-3717  
Source of Water: T89-131  
Division of Water Resources Permit #


X Groundwater 1375 Ft North from Southeast Corner (Well) 2450 Ft West from Southeast Corner of Sec 3 Twp 24S Rge 18 East X West  
Surface Water Ft North from Southeast Corner (Stream, pond etc) Ft West from Southeast Corner Sec Twp Rge East West  
Other (explain) (purchased from city, R.W.D. #)

INSTRUCTIONS: This form shall be completed in triplicate and filed with the Kansas Corporation Commission, 200 Colorado Derby Building, Wichita, Kansas 67202, within 120 days of the spud date of any well. Rule 82-3-130, 82-3-107 and 82-3-106 apply. Information on side two of this form will be held confidential for a period of 12 months if requested in writing and submitted with the form. See rule 82-3-107 for confidentiality in excess of 12 months. One copy of all wireline logs and drillers time log shall be attached with this form. Submit CP-4 form with all plugged wells. Submit CP-111 form with all temporarily abandoned wells.

All requirements of the statutes, rules and regulations promulgated to regulate the oil and gas industry have been fully complied with and the statements herein are complete and correct to the best of my knowledge.

Signature B. Lynn Herrington  
Title Executive Vice-President Date 7/3/89

Subscribed and sworn to before me this 3rd day of July 1989  
Notary Public Judith K. Moser  
Date Commission Expires May 17, 1993

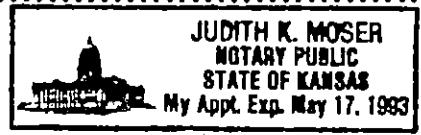

K.C.C. OFFICE USE ONLY  
 Letter of Confidentiality Attached  
 Wireline Log Received  
 Drillers Timelog Received  
Distribution  
 KCC  SWD/Rep  NGPA  
 KGS  Plug  Other (Specify)

Sec. 3, Twp. 24, Rge. 18

P1