

STATE CORPORATION COMMISSION OF KANSAS
OIL & GAS CONSERVATION DIVISION
WELL COMPLETION OR RECOMPLETION FORM
ACO-1 WELL HISTORY
DESCRIPTION OF WELL AND LEASE

Operator: License # 5118
Name TGT Petroleum Corp.
Address 209 E. William #165
City/State/Zip Wichita, Ks, 67202
Purchaser Clear Creek, Inc.
McPherson, Ks.
Operator Contact Person B. Lynn Herrington
Phone 262-6489
Contractor: License # 5422
Name Abercrombie Drilling, Inc.
Wellsite Geologist Al Sutde
Phone 943-4361


Designate Type of Completion
 New Well Re-Entry Workover
 Oil Gas Dry
 SWD Inj Other (Core, Water Supply etc.)
If **OWWO**: old well info as follows:
Operator
Well Name
Comp. Date
Old Total Depth

WELL HISTORY

Drilling Method:
 Mud Rotary Air Rotary Cable
3-15-89 3-25-89 5-12-89
Spud Date Date Reached TD Completion Date
4530' 4505'
Total Depth PBDT
Amount of Surface Pipe Set and Cemented at 416 feet
Multiple Stage Cementing Collar Used? Yes No
If yes, show depth set feet
If alternate 2 completion, cement circulated from feet depth to w/ SX cmt
Cement Company Name
Invoice #

API NO. 15-047-21,333-0000
County Edwards
C W/2 W/2 SE Sec 3 Twp 24S Rge 18 East
1320 2310 Ft North from Southeast Corner of Section
Ft West from Southeast Corner of Section
(Note: Locate well in section plat below)
Lease Name Britton Trust "A" Well #. 2
Field Name Nettleton
Producing Formation Lansing/KC
Elevation: Ground 2143 KB 2155

Section Plat

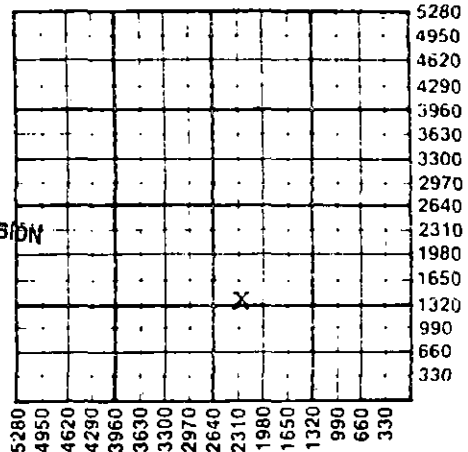

RECEIVED
STATE CORPORATION COMMISSION
JUL - 3 1989
CONSERVATION DIVISION
Wichita, Kansas

WATER SUPPLY INFORMATION

Disposition of Produced Water: Disposal
Docket # Repressuring

Questions on this portion of the ACO-1 call:

Water Resources Board (913) 296-3717
Source of Water: T89-131
Division of Water Resources Permit #
 Groundwater 1375 Ft North from Southeast Corner
(Well) 2450 Ft West from Southeast Corner of
Sec 3 Twp 24S Rge 18 East West
 Surface Water Ft North from Southeast Corner
(Stream, pond etc) Ft West from Southeast Corner
Sec Twp Rge East West
 Other (explain)
(purchased from city, R-W.D. #)

INSTRUCTIONS: This form shall be completed in triplicate and filed with the Kansas Corporation Commission, 200 Colorado Derby Building, Wichita, Kansas 67202, within 120 days of the spud date of any well. Rule 82-3-130, 82-3-107 and 82-3-106 apply. Information on side two of this form will be held confidential for a period of 12 months if requested in writing and submitted with the form. See rule 82-3-107 for confidentiality in excess of 12 months. One copy of all wireline logs and drillers time log shall be attached with this form. Submit CP-4 form with all plugged wells. Submit CP-111 form with all temporarily abandoned wells.

All requirements of the statutes, rules and regulations promulgated to regulate the oil and gas industry have been fully complied with and the statements herein are complete and correct to the best of my knowledge.

Signature B. Lynn Herrington
Title Executive Vice-President Date 7/3/89

Subscribed and sworn to before me this 3rd day of July 1989
Notary Public Judith K. Moser
Date Commission Expires May 17, 1993



K.C.C. OFFICE USE ONLY
 Letter of Confidentiality Attached
 Wireline Log Received
 Drillers Timelog Received
Distribution
 KCC SWD/Rep NGPA
 KGS Plug Other
(Specify)
7-3-89
Form ACO-1 (5-86)

Sec. 3, Twp. 24, Rge. 18