


15-095-01529000

Give All Information Completely  
Make Required Affidavit  
Mail or Deliver Report to:  
Conservation Division  
State Corporation Commission  
800 Bittling Building  
Wichita, Kansas

OR  
FORMATION PLUGGING RECORD

Strike out upper line  
when reporting plug-  
ging off formations.

NORTH

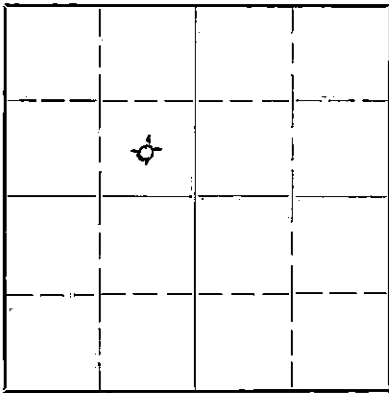

Locate well correctly on above  
Section Plat

Kingman

County. Sec. 8 Twp. 28 Rge. (E) 8 (W)

Location as "NE $\frac{1}{4}$ NW $\frac{1}{4}$ SW $\frac{1}{4}$ " or footage from lines. C. SE $\frac{1}{2}$  NW $\frac{1}{2}$

Lease Owner The Derby Oil Company

Lease Name Comanche Well No. 1

Office Address Wichita, Kansas

Character of Well (completed as Oil, Gas or Dry Hole) Dry Hole

Date well completed December 12 1943

Application for plugging filed " 14 1943

Application for plugging approved " 21 1943

Plugging commenced " 12 1943

Plugging completed " 12 1943

Reason for abandonment of well or producing formation

Dry Hole

If a producing well is abandoned, date of last production 19

Was permission obtained from the Conservation Division or its agents before plugging was com-  
menced? Yes

Name of Conservation Agent who supervised plugging of this well Ruel Durkes

Producing formation None Depth to top Bottom Total Depth of Well 4470 Feet

Show depth and thickness of all water, oil and gas formations.


OIL, GAS OR WATER RECORDS

CASING RECORD

Formation	Content	From	To	Size	Put In	Pulled Out
				8 5/8"	1172	None

Describe in detail the manner in which the well was plugged, indicating where the mud fluid was placed and the method or methods used in introducing it into the hold. If cement or other plugs were used, state the character of same and depth placed, from feet to feet for each plug set.

4470' to 300' Mud  
300' to 297' Wood Plug and Bridge  
297' to 217' Cement  
217' to 42' Mud  
42' to 39' Wood Plug and Bridge  
39' to 6' Cement and cap  
6' to Surface Earth

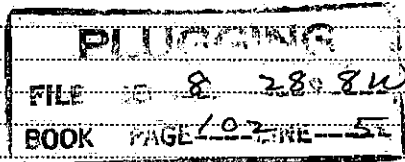

REC-2  
12-28-43

(If additional description is necessary, use BACK of this sheet)

Correspondence regarding this well should be addressed to The Derby Oil Company

Address Wichita, Kansas

STATE OF KANSAS, COUNTY OF SEDGWICK, ss.

S. E. Banks (employee of owner) or (owner or operator) of the above-described well,

being first duly sworn on oath, says: That I have knowledge of the facts, statements, and matters herein contained and the log of the above-described well as filed and that the same are true and correct. So help me God.

(Signature) S. E. Banks

Wichita, Kansas  
(Address)

SUBSCRIBED AND SWORN to before me this 28th day of December, 1943

My commission expires July 31, 1947

[Signature]  
Notary Public.



The Derby Oil Company

15-095-01529-0000

Record of Well No.	#1	Comanche	Farm
Location	CSE NW	Sec. 8	Twp. 28 Rge. 8W
Contractor	Crow Drilling Company	County	Kingman
Drilling Commenced	11/6/43	State	Kansas
Elevation	1548	Drilling completed	12/11/43

CASING RECORD

Size	Feet	Kind
8 5/8	1172	Surface 450 sax Bulk cement & 20 aquagel

Formation	Bottom	Formation	Bottom
Sand	0- 20	Broken Lime	2927
Blue Clay	65	Lime & Streaks chert	2975
Red bed	450	Lime	3033
Shale & shell	645	Shale Lime	3311
Lime shells	698	Shale	3348
Shale & shell	870	Shale & Lime	3399
Lime & shale	970	Cherty Lime	3416
Shale streaks & gravel	1022	Lime & streaks of chert	3489
Shale & anhydrite streaks	1055	Lime	3577
Salt & shale	1098	Shale & Lime	3597
Anhydrite	1130	Lime	3692
Lime & shales	1187	Lime & Shale	3716
Lime	1250	Shale & Lime streaks	3749
Anhydrite	1310	Lime & Shale	3799
Anhydrite & lime	1370	Shale	3808
Lime	1460	Shale & Lime	3848
Cherty Lime	1510	Shale & shells	3870
Lime	1586	Shale	3878
Sandy Lime	1627	Lime	3904
Lime	1691	Shale	3932
Cherty Lime	1722	Shale & Lime	3949
Lime	1725	Chat	3995
Cherty Lime	1765	Lime	4025
Lime & streaks chert	1785	Chat	4046
Broken Lime	1830	Lime	4054
Lime	1918	Lime & Shale	4138
Broken Lime & shales	1981	Shale	4165
Lime	2092	Shale & Lime Streaks	4172
Broken Lime	2165	Shale & Lime	4272
Sand Lime & Shale	2205	Shale	4280
Shale & Lime	2390	Lime	4362
Lime	2665	Sand & Shale	4381
Broken Lime	2718	Lime	4401
Sandy Lime	2784	Shale	4441
Lime	2848	Lime	4470

Geological Data

Tops:  
 Kans: 3276  
 Miss 3948  
 Simp. Sd 4328  
 Arb 4440  
 T.D. 4470  
 No sho - D&A

**PLUGGING**  
 FILE NO. 8 28 84  
 BOOK PAGE 42 LINE 5