

15-095-20961-0000


STATE OF KANSAS
STATE CORPORATION COMMISSION

WELL PLUGGING RECORD

Give All Information Completely
Make Required Affidavit.
Mail or Deliver Report to
Conservation Division
State Corporation Comm.
245 North Water
Wichita, KS 67202

Kingman County, Sec. 9 Twp. 28S Rge. 8W E/W
Location as "NE/CNW $\frac{1}{4}$ SW $\frac{1}{4}$ " or footage from lines
C-NW/4

Lease Owner Keener Oil Company
Lease Name P. J. McKenna Well No. 1
Office Address 320 S. Boston, Tulsa, Oklahoma 74103
Character of Well (Completed as Oil, Gas or Dry Hole)
Dry Hole

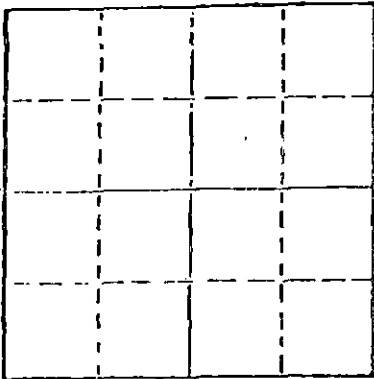

Locate well correctly on above
Section Plot

Date Well completed August 20, 1980
Application for plugging filed Verbal Application 19
Application for plugging approved Verbal Approval 19
Plugging commenced August 20, 1980
Plugging completed August 20, 1980
Reason for abandonment of well or producing formation

If a producing well is abandoned, date of last production 19

Was permission obtained from the Conservation Division or
its agents before plugging was commenced? Yes

Name of Conservation Agent who supervised plugging of this well William T. Owen
Producing formation Depth to top Bottom Total Depth of Well 3,983'
Show depth and thickness of all water, oil and gas formations.

OIL, GAS OR WATER RECORDS

CASING RECORD

| FORMATION | CONTENT | FROM | TO | SIZE | PUT IN | PULLED OUT |
|-----------|---------|------|----|--------|--------|------------|
| | | | | 8-5/8" | 226' | None |
| | | | | | | |
| | | | | | | |
| | | | | | | |

Describe in detail the manner in which the well was plugged, indicating where the mud fluid was placed and the method or methods used in introducing it into the hold. If cement or other plugs were used, state the character of same and depth placed, from feet to feet for each plug set.

Filled hole with heavy rotary mud from 3,983 ft. (rotary total depth) to 210 ft. Set plug at 210 ft. and cemented with 40 sacks cement. Filled hole with heavy rotary mud from 210 ft. to 40 ft. Set solid plug at 40 ft. and cemented to cellar with 10 sacks cement, 5 sacks cement in rat hole.

Plugging operations accomplished utilizing Halliburton Oil Well Cementing pump truck through 4 1/2 inch drill pipe.

(If additional description is necessary, use BACK of this sheet)

Name of Plugging Contractor Halliburton Services
410 Union Center Bldg., Wichita, Kansas 67202

STATE OF Kansas COUNTY OF Sedgwick, ss.
Dean Britting, Agent (employee of owner) xxxxxxxxxx operator



of the above-described well, being first duly sworn on oath, says: That I have knowledge of the facts, statements, and matters herein contained and the log of the above-described well as filed and that the same are true and correct. So help me God.

(Signature) Dean Britting
251 N. Water #10, Wichita, Kansas 67202
(Address)

SUBSCRIBED AND SWORN TO before me this 2nd day of September, 1980

Elsie Willison
Elsie Willison - Notary Public.

My commission expires July 25, 1982

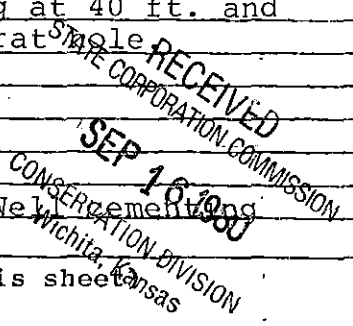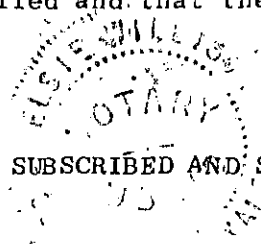

KANSAS DRILLERS LOG

COMPANY Keener Oil Company

SEC. 9 T. 28S R. 8W

FARM P. J. McKenna NO. 1

LOC. C-NW/4

COUNTY Kingman

ROTARY TOTAL DEPTH 3,983'

COMM. August 11, 1980 COMP. August 20, 1980

CONTRACTOR H-30, Inc. (Rig #11)

ISSUED September 2, 1980

CASING

10 3/4"

8 5/8" Set at 226' cemented w/225 sxs cement

5 1/2"

4 1/2"

ELEVATION 1,559' K.B.

FIGURES INDICATE BOTTOM OF FORMATIONS

| | |
|--------------------|--------|
| Shale and Red Bed | 410' |
| Shale | 1,307' |
| Shale and Lime | 3,090' |
| Lime and Shale | 3,500' |
| Shale and Lime | 3,585' |
| Lime | 3,983' |
| Rotary Total Depth | 3,983' |

I hereby certify the above and foregoing to be a true and correct log of the above described well as shown by the drilling reports.

H-30, INC.

Dean Britting
Dean Britting

State of Kansas)
County of Sedgwick) ss:

Subscribed and Sworn to before me a Notary Public in and for said county and state this 2nd day of September, 1980.

RECEIVED
STATE CORPORATION COMMISSION
SEP 16 1980
CONSERVATION DIVISION

WILLISON
NOTARY
1980

Elsie Willison
Elsie Willison - Notary Public

My Commission Expires:

July 25, 1982