

STATE OF KANSAS
STATE CORPORATION COMMISSION

WELL PLUGGING RECORD

Give All Information Completely
Make Required Affidavit
Mail or Deliver Report to:
Conservation Division
State Corporation Commission
212 No. Market
Wichita, Kansas

Kingman County, Sec. 11 Twp. 28S Rge. 8 (E) W (W)

Location as "NE/CNW/SW" or footage from lines SE NW

Lease Owner Lee Phillips Oil Company

Lease Name Simons Well No. 1

Office Address 1532 Wichita Plaza Bldg., Wichita, Kansas 67202

Character of Well (completed as Oil, Gas or Dry Hole) Dry Hole

Date well completed 5-25 1969

Application for plugging filed 5-25 1969

Application for plugging approved 5-25 1969


Plugging commenced 5-25 1969

Plugging completed 5-25 1969

Reason for abandonment of well or producing formation Dry Hole

If a producing well is abandoned, date of last production 19

Was permission obtained from the Conservation Division or its agents before plugging was commenced? Yes

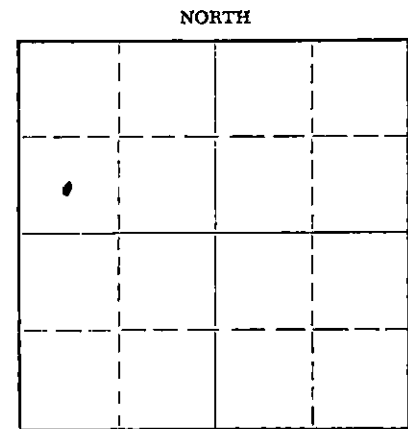

Locate well correctly on above Section Plat

Name of Conservation Agent who supervised plugging of this well Ralph Warren

Producing formation _____ Depth to top _____ Bottom _____ Total Depth of Well _____ Feet

Show depth and thickness of all water, oil and gas formations.

OIL, GAS OR WATER RECORDS

CASING RECORD

FORMATION	CONTENT	FROM	TO	SIZE	PUT IN	PULLED OUT
Surface pipe		-0-	306	8 5/8"	306	None

Describe in detail the manner in which the well was plugged, indicating where the mud fluid was placed and the method or methods used in introducing it into the hole. If cement or other plugs were used, state the character of same and depth placed, from _____ feet to _____ feet for each plug set.

- Filled hole with heavy mud.
- #1 plug @ 300' with 25 sks. cement.
- #2 plug @ 40' with 10 sks. cement.
- #3 plug in rat hole with 2 sks. cement.

RECEIVED
STATE CORPORATION COMMISSION
JUN 2 1969
CONSERVATION DIVISION
Wichita, Kansas

(If additional description is necessary, use BACK of this sheet)

Name of Plugging Contractor Sweetman Driling, Inc.

Address Box 645, Great Bend, Kansas 67530

STATE OF Kansas, COUNTY OF Barton, ss.

T. D. Sweetman (employee of owner) or (owner or operator) of the above-described well, being first duly sworn on oath, says: That I have knowledge of the facts, statements, and matters herein contained and the log of the above-described well as filed and that the same are true and correct. So help me God.

(Signature) T. D. Sweetman

Box 645, Great Bend, Kansas 67530

(Address)


SUBSCRIBED AND SWORN to before me this 28th day of May, 1969

Notary Public signature

Notary Public.

My commission expires

5-9-71

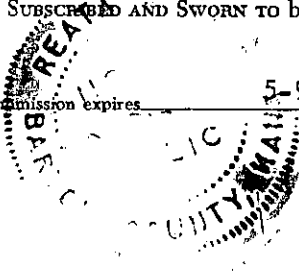

1509520154000

WELL LOG
Simons #1
(SE) NW 11-28S-8W
Kingman County, Kansas

FROM	TO		Elevation: 1536' DF
0	309	Red Bed and sand	
309	3310	Shale and lime	
3310	3989	Lime	
3989	4120	Miss.	
4120	4218	Lime	
4218	4283	Shale	
4283	4337	Lime	
4337		Total Depth	

RECEIVED
STATE CORPORATION COMMISSION
JUN 2 1969
CONSERVATION DIVISION
Wichita, Kansas

STATE OF KANSAS
COUNTY OF BARTON ss

T. D. Sweetman, President of Sweetman Drilling, Inc., being first duly sworn on oath says: That I have knowledge of the facts, statements and matters herein contained and the log of the above described well as filed and that the same are true and correct.

T. D. Sweetman
T. D. Sweetman

Subscribed and sworn before me this 28th day of May, 1969.

Leata L. Boyd
Notary Public Barton County

