


STATE OF KANSAS
STATE CORPORATION COMMISSION

15-095-00440000

Give All Information Completely
Make Required Affidavit
Mail or Deliver Report to:
Conservation Division
State Corporation Commission
211 No. Broadway
Wichita, Kansas

WELL PLUGGING RECORD

NORTH

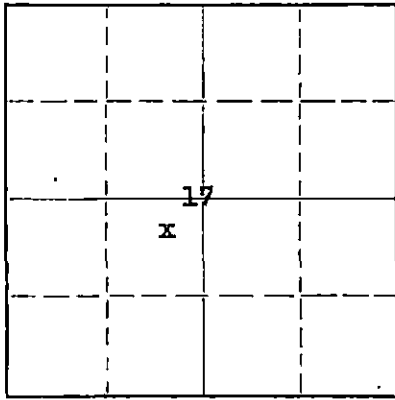

Locate well correctly on above
Section Plat

Kingman County, Sec. 17 Twp. 28 Rge. (E) 8 (W)
Location as "NE/CNW/SW" or footage from lines NE NE SW
Lease Owner Wilcox Oil Company
Lease Name Alfred Well No. 1
Office Address P.O. Box 1440 Tulsa, Oklahoma
Character of Well (completed as Oil, Gas or Dry Hole) Dry Hole
Date well completed March 31, 19 58
Application for plugging filed April 1, 19 58
Application for plugging approved April 7, 19 58
Plugging commenced April 1, 19 58
Plugging completed April 1, 19 58
Reason for abandonment of well or producing formation Dry Hole

If a producing well is abandoned, date of last production 19
Was permission obtained from the Conservation Division or its agents before plugging was commenced? No

Name of Conservation Agent who supervised plugging of this well Fred Hampel
Producing formation _____ Depth to top _____ Bottom _____ Total Depth of Well _____ Feet
Show depth and thickness of all water, oil and gas formations.

OIL, GAS OR WATER RECORDS

CASING RECORD

FORMATION	CONTENT	FROM	TO	SIZE	PUT IN	PULLED OUT
				8-5/8"	286'	None

Describe in detail the manner in which the well was plugged, indicating where the mud fluid was placed and the method or methods used in introducing it into the hole. If cement or other plugs were used, state the character of same and depth placed, from _____ feet to _____ feet for each plug set.

Filled hole with heavy mud up to 250' below surface. Set Halliburton plug
Dumped in 1/3 sack hulls, 20 sacks of cement. Filled pipe with heavy mud up to 35' from
top. Set another Halliburton plug, dumped 1/3 sack hulls and 10 sacks of cement. Filled
to top. Filled in cellar with earth.

STATE CORPORATION COMMISSION
APR 24 1958
DIVISION

(If additional description is necessary, use BACK of this sheet)
Name of Plugging Contractor D & M Drilling Company, Inc.
Address Great Bend, Kansas

STATE OF Oklahoma COUNTY OF Tulsa, ss.
Steve H. Helm (employee of owner) or (owner or operator) of the above-described well, being first duly sworn on oath, says: That I have knowledge of the facts, statements, and matters herein contained and the log of the above-described well as filed and that the same are true and correct. So help me God.
(Signature) Steve H. Helm
c/o Wilcox Oil Company, Box 1440, Tulsa, Okla. (Address)

SUBSCRIBED AND SWORN TO before me this 21 day of April, 19 58

Clara Alworth
Notary Public.

My commission expires 8-31-59

PLUGGING
FILE SEC 17 T 28 R 8 W
BOOK PAGE 921 E 5

15-095-004400000

ALFRED #1

NE/4 NE/4 SW/4 of Section 17-28-8, Kingman County, Kansas

Rigged up Rotary Tools 3/17/58

Ran 13 Jts. (286') 8 5/8" Used 32#
Surface Pipe set @ 286'. Cemented
w/200 sacks cement, 2% CC

Tore down Rotary Tools 4/1/58

<u>FORMATION</u>	<u>FROM</u>	<u>TO</u>
Sand & Redbed	0'	286'
Shale & shells	286	530
Lime, shells & shale	530	1050
Shale, shells	1050	1275
Anhydrite	1275	1310
Shale & lime	1310	1400
Lime & shale streaks	1400	1495
Lime, shells & shale	1495	1650
Lime & shale	1650	1780
Shale & lime streaks	1780	2025
Shale & shells	2025	2295
Shale	2295	2410
Shale & lime streaks	2410	2665
Lime & shale	2665	2825
Lime & shale streaks	2825	3030
Lime	3030	3125
Shale	3125	3153
Lime & shale Streaks	3153	3195
Sandy lime	3195	3210
Sand & shale	3210	3240
Shale & lime	3240	3280
Shale	3280	3377
Lime & shale	3377	3400
Lime	3400	3592
Lime & shale streaks	3592	3635
Lime	3635	3666
Hard lime	3666	3700
Lime	3700	3770
Lime & shale streaks	3770	3955
Lime	3955	4026
Mississippi	4026	4098 T.D.

I, W. M. Barnett, do hereby certify that the foregoing log is true and correct, to the best of my knowledge and belief.

PLUGGING
 FILE SEC. 17 T. 28 R. 8W
 BOOK PAGE 92 LINE 5

W. M. Barnett
W. M. Barnett

Subscribed and sworn to before me this 2nd day of April, 1958

James Lawrence
Notary Public

My Commission Expires: July 29, 1961