

STATE OF KANSAS
STATE CORPORATION COMMISSION

Form CP-4


Give All Information Completely
Make Required Affidavit
Mail or Deliver Report to:
Conservation Division
State Corporation Commission
212 No. Market
Wichita, Kansas

WELL PLUGGING RECORD

Kingman County, Sec. 4 Twp. 28S Rge. 10 ~~XX~~ W (W)
Location as "NE/CNW/SW" or footage from lines C SW NE

Lease Owner Mack Oil Co.
Lease Name Clayton Well No. 1
Office Address 812 Union Center Bldg., Wichita, Kansas 67202
Character of Well (completed as Oil, Gas or Dry Hole) Dry Hole
Date well completed July 4 1967
Application for plugging filed July 4 1967
Application for plugging approved July 4 1967
Plugging commenced July 5 1967
Plugging completed July 5 1967
Reason for abandonment of well or producing formation Dry

NORTH

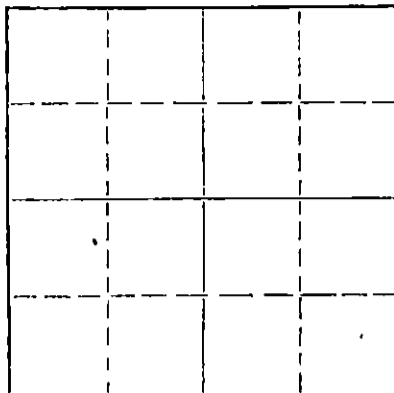

Locate well correctly on above Section Plat

If a producing well is abandoned, date of last production _____ 19____
Was permission obtained from the Conservation Division or its agents before plugging was commenced? Yes

Name of Conservation Agent who supervised plugging of this well Archie Elving, Pratt, Kansas
Producing formation None Depth to top _____ Bottom _____ Total Depth of Well 4433 Feet
Show depth and thickness of all water, oil and gas formations.

OIL, GAS OR WATER RECORDS

CASING RECORD

FORMATION	CONTENT	FROM	TO	SIZE	PUT IN	PULLED OUT

Describe in detail the manner in which the well was plugged, indicating where the mud fluid was placed and the method or methods used in introducing it into the hole. If cement or other plugs were used, state the character of same and depth placed, from _____ feet to _____ feet for each plug set.

Plugged with 30 sax common cement @ 250'
25 sax common cement @ 50'
5 sax common cement in rathole
Completed plugging @ 11:00 a.m., July 5, 1967

RECEIVED
STATE CORPORATION COMMISSION

JUL 7 1967
7-7-67

CONSERVATION DIVISION
Wichita, Kansas

(If additional description is necessary, use BACK of this sheet)

Name of Plugging Contractor MACK OIL CO.
Address P. O. Box 400, Duncan, Oklahoma 73533

STATE OF KANSAS, COUNTY OF SEDGWICK, ss.
Robert L. Harris (employee of owner) or (owner or operator) of the above-described well, being first duly sworn on oath, says: That I have knowledge of the facts, statements, and matters herein contained and the log of the above-described well as filed and that the same are true and correct. So help me God.

(Signature) Robert L. Harris
812 Union Center Bldg., Wichita, Kansas
(Address)

SUBSCRIBED AND SWORN TO before me this 6th day of July, 1967

My commission expires September 21, 1968

Elizabeth F. Nice
Elizabeth F. Nice
Notary Public.

RECEIVED
STATE CORPORATION COMMISSION

JUL 7 1967

MACK OIL CO.
Duncan, OklahomaCONSERVATION DIVISION
Wichita, KansasDRILLERS WELL LOG

#1 Clayton

Commenced R. D.: 6-25-67
Completed R. D.: 7- 4-67
Rotary Total Depth: 4433'C SW NE - Section 4-28S-10W
Kingman County, Kansas
Elevation: 1715' Kelly Bushing
Initial Production: Dry
Contractor: Mack Oil Co.

<u>STRATA</u>	<u>DEPTH</u>
Shale	0 - 499'
Shale & Sand	499 - 1200
Shale & Shells	1200 - 1707
Lime	1707 - 2330
Lime & Shale	2330 - 3025
Lime	3025 - 3305
Lime & Shale	3305 - 3558
Lime	3558 - 3943
Lime & Shale	3943 - 4033
Lime	4033 - 4410
Sand	4410 - 4413
Lime	4413 - 4433' - Total Depth

I hereby certify that the above is a true and correct log of said well as reflected by the daily drilling reports.

MACK OIL CO.

By Robert L. Harris
Robert L. Harris

Signed and sworn to in my presence this 5th day of July, 1967,
by Robert L. Harris, representative of Mack Oil Co.

Elizabeth F. Nice
Elizabeth F. Nice, Notary Public

My commission expires September 21, 1968