


STATE OF KANSAS
STATE CORPORATION COMMISSION

WELL PLUGGING RECORD

Give All Information Completely
Make Required Affidavit
Mail or Deliver Report to:
Conservation Division
State Corporation Commission
800 Bittling Building
Wichita, Kansas

KINGMAN County. Sec. 5 Twp. 28 Rge. (E) 10 (W)
Location as "NE/CNW $\frac{1}{4}$ SW $\frac{1}{4}$ " or footage from lines G. SW SW SW
Lease Owner PARCO & LEBOW
Lease Name SPAIN Well No. I
Office Address WICHITA KANSAS
Character of Well (completed as Oil, Gas or Dry Hole) DRY HOLE
Date well completed 2-16-51 19
Application for plugging filed oran 2-16-51 19
Application for plugging approved 2-16-51 19
Plugging commenced 2-16-51 19
Plugging completed 2-16-51 19
Reason for abandonment of well or producing formation

NORTH

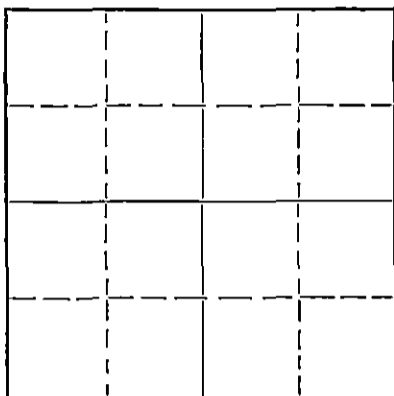

Locate well correctly on above
Section Plat

If a producing well is abandoned, date of last production 19
Was permission obtained from the Conservation Division or its agents before plugging was commenced? yes

Name of Conservation Agent who supervised plugging of this well Roul Durkee
Producing formation Depth to top Bottom Total Depth of Well 4553 Feet
Show depth and thickness of all water, oil and gas formations.

OIL, GAS OR WATER RECORDS

CASING RECORD

Formation	Content	From	To	Size	Put In	Pulled Out

Describe in detail the manner in which the well was plugged, indicating where the mud fluid was placed and the method or methods used in introducing it into the hole. If cement or other plugs were used, state the character of same and depth placed, from feet to feet for each plug set.

Pushed plug No. 1 to 300' and cemented with 15 sx cement. Pushed Plug No. 2 to 30' and cemented with 5 sx cement.

2-20-51

RECEIVED
STATE CORPORATION COMMISSION
FEB 20 1951
CONSERVATION DIVISION
Wichita, Kansas

(If additional description is necessary, use BACK of this sheet)

Correspondence regarding this well should be addressed to PARCO DRILLING, INC.
Address 818 CENTRAL BUILDING
WICHITA KANSAS

STATE OF KANSAS, COUNTY OF SEDGWICK, ss.
D. J. BRIGGS (employee of owner) or (owner or operator) of the above-described well,
being first duly sworn on oath, says: That I have knowledge of the facts, statements, and matters herein contained and the log of the above-described well as filed and that the same are true and correct. So help me God.

(Signature) D. J. Briggs
D. J. Briggs
Wichita Kansas
(Address)

SUBSCRIBED AND SWORN to before me this 19 day of February, 19 51

Ruth M. Gardner
Notary Public.

My commission expires March 2, 1953

PLUGGING
FILE SEC 5 T 28 R 10W
BOOK PAGE 62 LINE 4

D R I L L E R S L O G

COMPANY: PABCO DRILLING INC.-SIMON LEBOW LOCATION: C SW SW SW
 CONTRACTOR: PABCO DRILLING, INC. 5-28S-10W
 Kingman Co
 Kansas

FARM NAME: No. I SPAIN

COMMENCED: 1-23-51 PRODUCTION: D & A
 COMPLETED: 2-16-51

CASING USED:
 8 5/8" 406' cem w/225 sx

Sand & Redbed	90	
Shale & Shells	325	
Shale & Shells	406	
Redbed & Shale	640	ST OK 500
Shale & Shells	1200	
Lime	1435	
Lime & Shale	1830	
Lime	1895	
Lime & Shale	2135	SLM OK @ 2000
Lime	2295	
Shale & Lime	2425	
Lime	3175	SLM & ST OK @ 3000
Lime & Shale	3298	
Lime	3601	
Lime & Shale	4070	SLM & ST OK @ 4000
Lime	4082	DST
Shale	4159	
Lime & Shale	4215	
Shale	4268	
Lime	4379	
Shale & Lime	4438	DST @ 4441½
Sand & Shale	4441	
Shale & Sand	4443	DST
Shale	4468	
Shale & Sand	4481	
Lime	4553	
Total Depth	4553	

STATE OF KANSAS)
) SS:
 COUNTY OF SEDGWICK)

I, D. J. Briggs, do hereby certify that the above is a true and correct copy of the log on the above captioned well, as shown on the daily drilling reports.

PABCO DRILLING, INC.

D. J. Briggs
 E. J. Briggs

Subscribed and sworn to before me this 19th day of February 1951.

Ruth M. Gardner
 Notary Public

My commission expires March 2, 1953.

2-20-51

PLUGGING
 FILE SEC 5 T 28 R 10W
 BOOK PAGE 63 LINE 4

RECEIVED
 STATE CORPORATION COMMISSION
 FEB 20 1951
 CONSERVATION DIVISION
 Wichita, Kansas