


WELL PLUGGING RECORD

Give All Information Completely
Make Required Affidavit
Mail or Deliver Report to:
Conservation Division
State Corporation Commission
800 Bitting Building
Wichita, Kansas

Edwards County, Sec. 35 Twp. 24S Rge. (E) 18 (W)

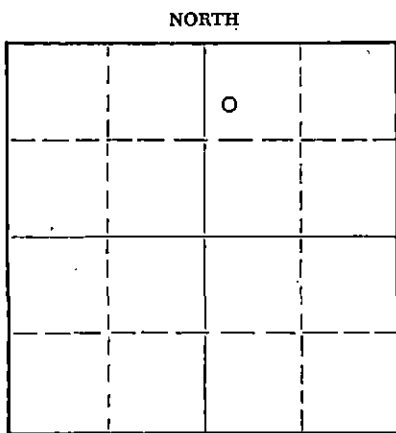

Locate well correctly on above Section Plat

Location as "NE/CNW/SW" or footage from lines SW NW NE
Lease Owner Natural Gas and Oil Company, etal
Lease Name FOX Well No. 1
Office Address 1009 Central Building, Wichita 2, Kansas
Character of Well (completed as Oil, Gas or Dry Hole) dry hole
Date well completed June 21, 1954 19
Application for plugging filed June 24, 1954 (written) 19
Application for plugging approved June 21, 1954 (orally) 19
Plugging commenced June 21, 1954 19
Plugging completed June 21, 1954 19
Reason for abandonment of well or producing formation _____

If a producing well is abandoned, date of last production _____ 19
Was permission obtained from the Conservation Division or its agents before plugging was commenced? yes

Name of Conservation Agent who supervised plugging of this well M. A. Rives, Box 8, Pratt, Kansas
Producing formation _____ Depth to top _____ Bottom _____ Total Depth of Well _____ Feet
Show depth and thickness of all water, oil and gas formations.

OIL, GAS OR WATER RECORDS

CASING RECORD

FORMATION	CONTENT	FROM	TO	SIZE	PUT IN	PULLED OUT
surface		0	205	10 3/4"	205	none

Describe in detail the manner in which the well was plugged, indicating where the mud fluid was placed and the method or methods used in introducing it into the hole. If cement or other plugs were used, state the character of same and depth placed, from _____ feet to _____ feet for each plug set.

Filled hole with heavy mud from total depth 5044 to 200 feet
Set plug at 200 feet and ran 20 sacks cement to 150 feet
Filled with heavy mud from 150 to 25 feet
Set plug at 25 feet and capped with 15 sacks cement

RECEIVED
STATE CORPORATION COMMISSION
JUN 26 1954

6-26-54

CONSERVATION DIVISION
Wichita, Kansas

(If additional description is necessary, use BACK of this sheet)
Name of Plugging Contractor Harms-Burt Drilling Company
Address P O Box 184, Great Bend, Kansas

STATE OF Kansas COUNTY OF Sedgwick ss.
John D. Carey (employee of owner) or ~~owner~~ of the above-described well, being first duly sworn on oath, says: That I have knowledge of the facts, statements, and matters herein contained and the log of the above-described well as filed and that the same are true and correct. So help me God.

(Signature) John D. Carey
1009 Central Building, Wichita 2, Kansas
(Address)

SUBSCRIBED AND SWORN TO before me this 25th day of June, 19 54

Esther Unsell
Notary Public.

My commission expires May 25, 1957

PLUGGING
FILE SEC 35-24-18W
BOOK PAGE 43 LINE 9

DRILLER'S LOG

COMPANY: Natural Gas and Oil Company, a division of
Mississippi River Fuel Corporation, etal

FARM: Fox #1, SW NW NE Sec. 35-24S-18W,
Edwards County, Kansas

COMMENCED: June 1, 1954

COMPLETED: June 21, 1954

ELEVATION: 2155 RB

0	to	35	Sand and clay
35	to	115	Sand
115	to	172	Sand and red bed
172	to	205	Shale and shells
205	to	495	Sand and shale
495	to	745	Red bed
745	to	770	Sand
770	to	1215	Red bed and sand streaks
1215	to	1235	Anhydrite
1235	to	1375	Shale and shells
1375	to	1675	Shale and shells w/salt
1675	to	2150	Shale and shells
2150	to	2245	Lime w/shale streaks
2245	to	2550	Lime
2550	to	2625	Lime and shale
2625	to	2745	Broken lime and shale
2745	to	3635	Lime and shale
3635	to	3660	Lime
3660	to	3800	Shale and lime
3800	to	3856	Shale
3856	to	4010	Lime and shale
4010	to	4295	Lime
4295	to	4505	Lime and shale
4505	to	4507	Sand
4507	to	4531	Sandy shale
4531	to	4543	Lime and chert
4543	to	4579	Shale and chert
4579	to	4623	Lime and chert
4623	to	4626	Misner Sand
4626	to	4680	Sand and shale
4680	to	4714	Lime and chert
4714	to	4755	Lime-shale and chert
4755	to	4810	Lime and chert
4810	to	4845	Lime
4845	to	4877	Lime and chert
4877	to	4938	Lime and shale
4938	to	4982	Lime, shale and chert
4982	to	5044	Lime
		5044	T. D.

RECEIVED
STATE CONSERVATION COMMISSION
JUN 26 1954
CONSERVATION DIVISION
Wichita, Kansas

Set 205 feet of 10 3/4" surface pipe. Cemented with 250 sacks cement and 4 sacks calcium chloride.

TOPS: Anhydrite	1215	Mississippi	4567	Viola	4698
Heebner	3850	Kinderhook	4612	Simpson	4937
Brn Lime	3979	Misner	4618	Arbuckle	5008
Lansing	3995				

DRILLSTEM TESTS: 4491-4507, open 1 hr, SI 30 min, weak
blow 7 min, rec. 5 ftmud, 12# BHP.

#2 4533-43, open 1 hr, SI 30 min, weak
blow 22 min, rec 10 ft mud, 140# BHP.

Ran Schlumberger
DRY, PLUGGED AND ABANDONED


PLUGGING

FILE SEC 35 T 24 R 18W


PAGE 43 LINE 9

C E R T I F I C A T E

I, John D. Carey, do hereby certify that the above and foregoing is a true and correct copy of the log of the Fox #1, SW NW NE Section 35-24S-18W, Edwards County, Kansas, as reflected by files of the Natural Gas and Oil Company, a division of Mississippi River Fuel Corporation.

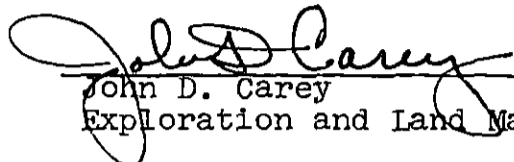
John D. Carey
Exploration and Land Manager

Subscribed and sworn to, before me, a Notary Public, within and for Sedgwick County, Kansas, this 25th day of June, 1954.


Esther Unsell, Notary Public

My commission expires May 25, 1957