


STATE OF KANSAS  
STATE CORPORATION COMMISSION

WELL PLUGGING RECORD

Give All Information Completely  
Make Required Affidavit  
Mail or Deliver Report to  
Conservation Division  
State Corporation Comm.  
245 North Water  
Wichita, KS 67202

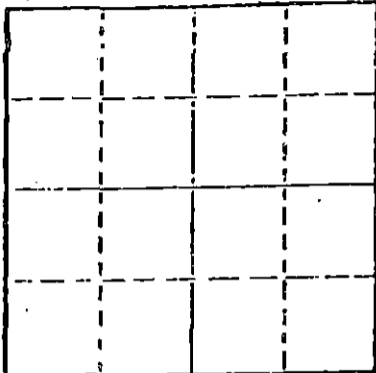

Locate well correctly on above  
Section Plat

Edwards County. Sec. 11 Twp. 21S Rge. 17W E/W  
Location as "NE/CNW/SW" or footage from lines  
440' FNL; 440' FWL, SW/4  
Lease Owner F. G. Holl, et al  
Lease Name Aldrich #2 Well No. #2-1  
Office Address 6427 East Kellogg, Wichita, Kansas 67207  
Character of Well (Completed as Oil, Gas or Dry Hole)

Dry Hole  
Date Well completed June 1, 1978 19  
Application for plugging filed June 1, 1978 19  
Application for plugging approved June 1, 1978 19  
Plugging commenced 4:00 PM - June 1, 1978 19  
Plugging completed 7:00 PM - June 1, 1978 19  
Reason for abandonment of well or producing formation

Dry Hole  
If a producing well is abandoned, date of last production 19  
Was permission obtained from the Conservation Division or its agents before plugging was commenced? Yes

Name of Conservation Agent who supervised plugging of this well Duane Rankin  
Producing formation Depth to top Bottom Total Depth of Well 4485'  
Show depth and thickness of all water, oil and gas formations.

OIL, GAS OR WATER RECORDS CASING RECORD

FORMATION	CONTENT	FROM	TO	SIZE	PUT IN	PULLED OUT
				8 5/8"	267'	None

Describe in detail the manner in which the well was plugged, indicating where the mud fluid was placed and the method or methods used in introducing it into the hold. If cement or other plugs were used, state the character of same and depth placed, from feet to feet for each plug set.

Filled hole with heavy mud.  
Pumped thru open ended D.P. 40 sacks at 540';  
40 sacks at 240'; Solid Bridge at 40' with  
Plug and 1/2 sack hulls; 12 sacks cement to  
surface. 3 sacks in rathold. Used 50/50 Pozmix  
cement.

6-8-78  
REC  
STATE CORPORATION  
JUN 6 1978

(If additional description is necessary, use BACK of this sheet)  
Name of Plugging Contractor Sterling Drilling Company  
P. O. Box 129, Sterling, Kansas 67579

STATE OF KANSAS COUNTY OF RICE ss.  
F. A. Wuellner (employee of owner) or (owner or operator) of the above-described well, being first duly sworn on oath, says: That I have knowledge of the facts, statements, and matters herein contained and the log of the above-described well as filed and that the same are true and correct. So help me God. STERLING DRILLING COMPANY

(Signature) F. A. Wuellner  
F. A. Wuellner, Secretary  
P. O. Box 129, Sterling, Kansas 67579  
(Address)

SUBSCRIBED AND SWORN TO before me this 2nd day of June 1978



Charles M. Hall, Notary Public.

STERLING DRILLING COMPANY  
 P. O. Box 129  
 Sterling, Kansas 67579

WELL LOG - - - - - ALDRICH #2-4  
 Located: 440' FNL; 440' F.L, SW/4, Sec. 4-24S-17W, Edwards  
 County, Kansas

OWNER: F. G. Holl, et al  
 ROTARY DRILLING CONTRACTOR: Sterling Drilling Company

COMMENCED: May 25, 1978  
 COMPLETED: June 1, 1978

TOTAL DEPTH: 4485'

<u>LOG</u>	<u>CASING RECORD</u>
0 - 375 Sand and Shale	Ran 7 joints used 28%, 8 5/8" casing, 254.95' set at 267' K.B. with 225 sacks
375 - 1167 Shale, Sand and Red Bed.	60/40 Pozmix with 35 cc. Plug down at 2:15 PM, 5-25-78, by Howco.
1167 - 1186 Anhydrite	
1196 - 1410 Shale	
1410 - 2090 Shale and Lime Stgs.	
2090 - 4315 Lime and Shale	
4315 - 4354 Lime and Sand	
4354 - 4360 Lime	
4360 - 4375 Lime and Shale	
4375 - 4403 Chert (Miss.)	
4403 - 4435 Cherty Lime and Shale	
4435 - 4485 Lime and Shale	Plugged.

RECEIVED  
 JUN 10 1978