

WELL PLUGGING RECORD

Give All Information Completely
Make Required Affidavit
Mail or Deliver Report to:
Conservation Division
State Corporation Commission
211 No. Broadway
Wichita, Kansas

Edwards County. Sec. 16 Twp. 24S Rge. (E) 19 (W)

Location as "NE/CNW/SW" or footage from lines 370' FSL & 950' FWL

Lease Owner Kewanee Oil Company

Lease Name Shin Well No. 1

Office Address P. O. Box 360, Hoisington, Kansas

Character of Well (completed as Oil, Gas or Dry Hole) Dry Hole

Date well completed August 6, 19 56

Application for plugging filed August 6, 19 56

Application for plugging approved File 88-12 August 6, 19 56


Plugging commenced August 6, 19 56

Plugging completed August 6, 19 56

Reason for abandonment of well or producing formation Dry Hole

If a producing well is abandoned, date of last production 19

Was permission obtained from the Conservation Division or its agents before plugging was commenced? Yes

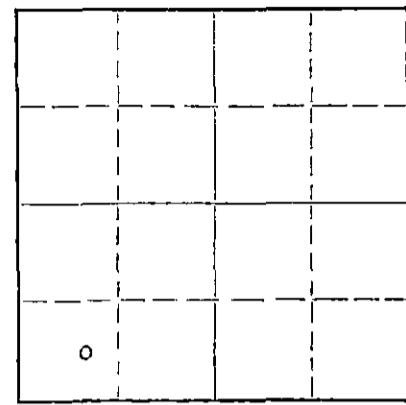

Locate well correctly on above Section Plat

Name of Conservation Agent who supervised plugging of this well M. A. Rives

Producing formation _____ Depth to top _____ Bottom _____ Total Depth of Well 5015 Feet

Show depth and thickness of all water, oil and gas formations.

OIL, GAS OR WATER RECORDS

CASING RECORD

FORMATION	CONTENT	FROM	TO	SIZE	PUT IN	PULLED OUT
Lansing - Kansas City	Dry	3985	4325	8-5/8"	254	0
Mississippi Chat	Dry	4534				
Mississippi Lime	Dry	4603				
Kinderhook	Dry	4630				
Arbuckle	Dry	4963	5015	5-1/2"	4619	2697

Describe in detail the manner in which the well was plugged, indicating where the mud fluid was placed and the method or methods used in introducing it into the hole. If cement or other plugs were used, state the character of same and depth placed, from _____ feet to _____ feet for each plug set.

Measured into Total Depth (Plug Back) 4598'
Plugged off bottom with sand to 4550' and dumped 50 sacks cement with bailer and shot 5 1/2" casing at 3990'; 3877'; 3851'; 3010' and 2685'. Pulled pipe out of hole and plugged well with heavy mud to 300' and set permanent rock bridge. Dumped 20 sacks cement. Filled hole with heavy mud to 40' and mixed 10 sacks for cap on well.

(If additional description is necessary, use BACK of this sheet)

Name of Plugging Contractor J. O. Forbes d/b/a Forbes Casing Pulling Company

Address Box 221, Great Bend, Kansas

STATE OF Kansas, COUNTY OF Barton, ss.
R. S. Allison (employee of owner) or (owner or operator) of the above-described

well, being first duly sworn on oath, says: That I have knowledge of the facts, statements, and matters herein contained and the log of the above-described well as filed and that the same are true and correct. So help me God.

(Signature) *R. S. Allison*

P. O. Box 360, Hoisington, Kansas (Address)

SUBSCRIBED AND SWORN TO before me this 10th day of August 19 56

My commission expires May 26, 1958

Josephine E. Poor Notary Public.

RECEIVED CORPORATION COMMISSION

AUG 13 1956 8-13-56

CONSERVATION DIVISION
Wichita, Kansas

PLUGGING
FILE SEC. 16 T. 24 R. 19W
BOOK PAGE 88 LINE 12

SHIN #1

Well Record

Location: SE/4 NW/4 SW/4 Sec. 16-245-19W
 Edwards County, Kansas

Operator: Kewanee Oil Company
 548 Petroleum Building
 Wichita, Kansas

Contractor: Graham-Michaelis Drilling Company
 1003 East Second Street
 Wichita 1, Kansas

Casing Record: 8-5/8" @ 254.24" w/200 sacks cement
 5-1/2" @ 4619" w/100 sacks cement

Commenced: June 25, 1956
 Completed: July 17, 1956
 (rotary)

LOG

Sand & Clay	257
Shale & Red Bed	987
Shale	1834
Shale & Red Bed	2065
Shale & Lime	2452
Lime	2653
Shale & Lime	3677
Lime	3828
Lime & Shale	3947
Sandy Shale & Lime	3997
Lime	4538
Miss. Chert	4591
Lime & Chert.	4632
Lime & Sand	4693
Lime	4640
Sand	4742
Lime & Chert.	4753
Lime	4909
Lime & Sand	4963
Lime	4994
Arbuckle	5015, RTD

STATE OF KANSAS)
) ss.
 COUNTY OF SEDGWICK)

The undersigned, GRAHAM-MICHAELIS DRILLING COMPANY, hereby certifies that the above log is a true and correct log of the formations encountered in drilling the above well as reflected by the Daily Drilling Report.

GRAHAM-MICHAELIS DRILLING COMPANY

By John L. James
 John L. James
 Geologist.

Subscribed and sworn to before me
 this twenty-third day of July, 1956.

Mary L. Barney

My commission expires: 11/7/57.

RECEIVED
 STATE CORPORATION COMMISSION
 AUG 13 1956

PLUGGING
 FILE SEC. 16 T. 24 R. 19W.
 BOOK PAGE 88 LINE 12

CONSERVATION DIVISION
 WICHITA, KANSAS