


STATE OF KANSAS  
STATE CORPORATION COMMISSION

Give All Information Completely  
Make Required Affidavit  
Mail or Deliver Report to  
Conservation Division  
State Corporation Commission  
800 Bittling Building  
Wichita, Kansas

WELL PLUGGING RECORD  
OR  
FORMATION PLUGGING RECORD

Strike out upper line  
when reporting plug-  
ging off formations.

NORTH

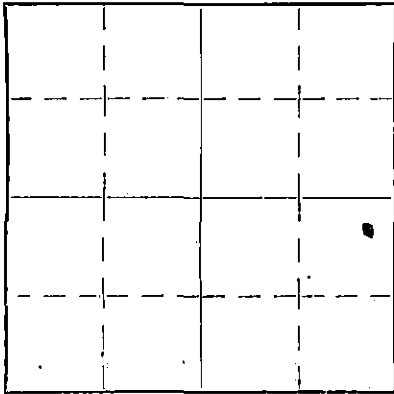

Locate well correctly on above  
Section Plat

*Edwards* County. Sec. 17 Twp. 24 Rge. 1 (E) W (W)  
Location as "NE $\frac{1}{4}$ NW $\frac{1}{4}$ SW $\frac{1}{4}$ " or footage from lines \_\_\_\_\_

Lease Owner \_\_\_\_\_  
Lease Name Krupp Well No. 011  
Office Address \_\_\_\_\_  
Character of Well (Completed as Oil, Gas or Dry Hole) Dry Hole  
Date, well completed June 3 1937  
Application for plugging filed June 3 1937  
Application for plugging approved June 3 By phone 1937  
Plugging Commenced June 13 1937  
Plugging Completed June 13 1937  
Reason for abandonment of well or producing formation Dry Hole

If a producing well is abandoned, date of last production No Pro. 1937

Was permission obtained from the Conservation Division or its agents before plugging was commenced?  
Yes

Name of Conservation Agent who supervised plugging of this well Permission Granted by J. A. Morgan of Wichita June 3 1937

Producing formation None Depth to top \_\_\_\_\_ Bottom \_\_\_\_\_ Total Depth of Well 323.5 Feet.

Show depth and thickness of all water, oil and gas formations.

OIL, GAS OR WATER RECORDS CASING RECORD

Formation	Content	From	To	Size	Put In	Pulled Out
				15 1/4"	320	None
				1-31-38		

Describe in detail the manner in which the well was plugged, indicating where the mud fluid was placed and the method or methods used in introducing it into the hole. If cement or other plugs were used, state the character of same and depth placed, from \_\_\_\_\_ feet to \_\_\_\_\_ feet for each plug set.

320 feet for each plug set.  
Hole free by mud, heavy mud & thin, from 320 to 305 then was  
filled with cement. Only 15 1/4" dry hole plug on top of  
cement. From 305 to 15 ft heavy mud with dry hole &  
plug set at 15 feet. From 15 ft to surface - Cement.  
Mud + Cement pumped into well through 6" drill pipe

**PLUGGING**  
FILE SEC-17-T-24-R-194  
BOOK PAGE 92-LINE-38

*pl-113/138*  
*W*

Correspondence regarding this well should be addressed to \_\_\_\_\_  
Address Box 621 - Russell, Kansas

STATE OF Oklahoma, COUNTY OF Zulma, ss.

\_\_\_\_\_, (employee of owner) or (owner or operator) of the above-described well,  
being first duly sworn on oath, says: That I have knowledge of the facts, statements, and matters herein contained and the log of the above-described  
well as filed and that the same are true and correct. So help me God.

(Signature) W E Stickle  
1214 Atlas Life Bldg, Zulma Oklahoma  
(Address)

SUBSCRIBED AND SWORN to before me this 17 day of January, 1938

My commission expires 2/16/39  
Paul W. Donnelly  
Notary Public.

WELL LOG BUREAU - KANSAS GEOLOGICAL SOCIETY  
412 Union National Bank Bldg, Wichita, Kansas.

J. E. MABEE CO.  
Krupp No. 1


SEC. 18 T. 24 R. 19W.  
C NE SE

Total Depth. 5155  
Comm. 4-2-37 Comp. 6-13-37  
Shot or Treated.  
Contractor. J. E. Mabee Co.  
Issued. 10-2-37

County Edwards

CASING.

15 1/2" 320'

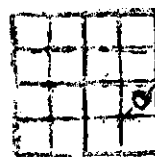

Elevation.

Production. DRY.

Figures Indicate Bottom of Formations.

sand and shale	315
shale and shells	566
shale shells and red bed	1510
shale and lime	2035
shale and shells	2342
broken lime	2409
lime hard	2615
sidetracked hole from 2140	
lime and shale	2789
lime	2834
sand and lime	2844
lime	2976
shale and lime	3088
lime	3098
lime and shale	3260
shale	3363
lime	3400
shale and lime	3473
sand and lime	3550
shale and lime	3570
lime	3825
lime and shale	3924
lime	4040
shale	4083
K.C. lime	4430
shale and lime	4542
lime	4567
shale and lime	4640
conglomerate chat	4697
lime	4819
lime and shale	4860
lime	4910
shale	4920
lime	5015
lime and shale	5023
sand and lime	5047
lime and shale	5079
lime	5135

Total Depth.

**PLUGGING**  
FILE SEC 17 T 24 R 19W  
BOOK PAGE 93 LINE 38

