


STATE OF KANSAS
STATE CORPORATION COMMISSION

Give All Information Completely
Make Required Affidavit
Mail or Deliver Report to:
Conservation Division
State Corporation Commission
800-Bitting Building
Wichita, Kansas

WELL PLUGGING RECORD

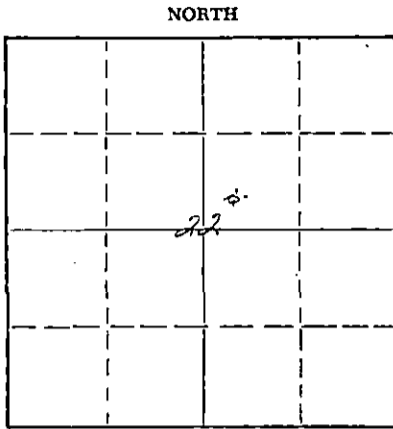

Locate well correctly on above
Section Plat

Edwards County, Sec. 22 Twp. 21 Rge. 19 (E) (W)
Location as "NE/CNW/SW" or footage from lines SW/4 SW/4 NE/4
Lease Owner Coppinger Drilling, Inc., & Wm I Rodgers
Lease Name Fox Well No. 1
Office Address 320 Union Natl Bk Bldg., Wichita, Kansas
Character of Well (completed as Oil, Gas or Dry Hole) dry hole
Date well completed June 27 19 55
Application for plugging filed same 19
Application for plugging approved same 19
Plugging commenced same 19
Plugging completed same 19
Reason for abandonment of well or producing formation

If a producing well is abandoned, date of last production 19
Was permission obtained from the Conservation Division or its agents before plugging was commenced? yes

Name of Conservation Agent who supervised plugging of this well Merle Rives, Pratt, Ks.
Producing formation Depth to top Bottom Total Depth of Well 1567 Feet
Show depth and thickness of all water, oil and gas formations.

OIL, GAS OR WATER RECORDS

CASING RECORD

| FORMATION | CONTENT | FROM | TO | SIZE | PUT IN | PULLED OUT |
|-----------|---------|------|----|--------|--------|------------|
| | | | | 8-5/8" | 250 | none |
| | | | | | | |
| | | | | | | |
| | | | | | | |
| | | | | | | |
| | | | | | | |

Describe in detail the manner in which the well was plugged, indicating where the mud fluid was placed and the method or methods used in introducing it into the hole. If cement or other plugs were used, state the character of same and depth placed, from feet to feet for each plug set.

Filled hole with mud laden fluid to 250' from top;
pushed plug to 250' from top;
filled with 20 sax cement to 35' of top;
cemented with 10 sax cement.

(If additional description is necessary, use BACK of this sheet)

Name of Plugging Contractor Coppinger Drilling, Inc.
Address 320 Union Natl Bk Bldg., Wichita

STATE OF Kansas, COUNTY OF Sedgwick, ss.
Lee Poulsen (employee of owner) or (owner or operator) of the above-described

well, being first duly sworn on oath, says: That I have knowledge of the facts, statements, and matters herein contained and the log of the above-described well as filed and that the same are true and correct. So help me God.

(Signature) Lee Poulsen
Lee Poulsen
320 Union Natl Bk Bldg., Wichita (Address)

SUBSCRIBED AND SWORN TO before me this 28th day of June, 19 55

My commission expires March 7, 1956

Mayree Broadbent Notary Public.
STATE CORPORATION COMMISSION

JUN 29 1955

CONSERVATION DIVISION
Wichita, Kansas

PLUGGING
REC SEC 22 T 24 R 19 W
PAGE 130 LINE 20

DRILLERS LOG

Contractor: Coppinger Drilling, Inc.
320 Union Natl Bk Bldg.
Wichita 2, Kansas

Coppinger Drilling, Inc., et al
Fox #1 - SW SW NE
Section 22-24s-19w
Edwards County, Kansas

Drilling commenced: June 10, 1955
Drilling completed: June 27, 1955

Elevation: 2155' R.B.
2153' D.F.

| | |
|------------------------|------|
| Gravel | 50 |
| Clay | 100 |
| Shale and shells | 400 |
| Red bed | 765 |
| Sand | 825 |
| Shale and red bed | 1170 |
| Shale | 1270 |
| Anhydrite | 1300 |
| Shale and shells | 1760 |
| Salt | 1870 |
| Shale and shells | 1975 |
| Shale and lime | 2355 |
| Lime | 2695 |
| Lime and shale | 3530 |
| Shale | 3605 |
| Shale and lime | 3664 |
| Lime | 3720 |
| Lime and shale | 4030 |
| Lime | 4345 |
| Lime and shale | 4480 |
| Shale, lime & Chert | 4530 |
| Lime and Chert | 4557 |
| Chert | 4567 |
| R T D | 4567 |
| D&A | |

Casing Record:

8-5/8" set at 250' w/175 sac cement

Tops: (Sample)

| | |
|--------------------|------|
| Anhydrite | 1270 |
| Heebner | 3860 |
| Brown Lime | 3971 |
| Lansing | 3980 |
| Base Kansas City | 4306 |
| Cherokee Sand | 4518 |
| Shaly Conglomerate | 4531 |
| Mississippi | 4547 |
| R T D | 4567 |

Dry and abandoned.

State of Kansas
County of Sedgwick, ss.

RECEIVED
STATE CORPORATION COMMISSION
JUN 29 1955
CONSERVATION DIVISION
Wichita, Kansas

I hereby certify that the above information is true and correct to the best of my knowledge.

Lee Poulsen
Lee Poulsen

Subscribed and sworn to before me this 28th day of June, 1955.

My Commission expires: March 7, 1956

Mayree Broadbus
Mayree Broadbus, Notary Public



PLUGGING
WELL NO. 22-T-24-19W
BOX PAGE 130 LINE 30