


STATE OF KANSAS
STATE CORPORATION COMMISSION

WELL PLUGGING RECORD

Give All Information Completely
Make Required Affidavit
Mail or Deliver Report to:
Conservation Division
State Corporation Commission
800 Bittling Building
Wichita, Kansas

NORTH

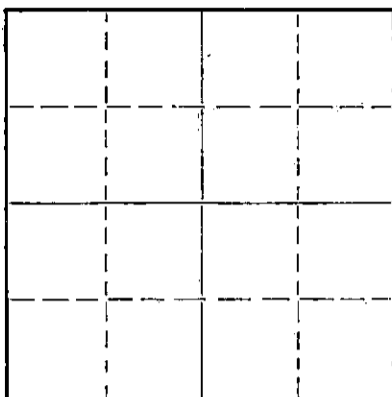

Locate well correctly on above
Section Plot

Stafford County. Sec. 17 Twp 24 Rge. (E) 11 (W)
Location as "NE/CNW $\frac{1}{4}$ SW $\frac{1}{4}$ " or footage from lines SE/4 NW/4
Lease Owner J.D. Ferrell Drilling Co., Inc. & Crown Oil Co., Inc.
Lease Name Piepmeier Well No. 1
Office Address Box 163, Great Bend, Kansas.
Character of Well (completed as Oil, Gas or Dry Hole) Dry Hole
Date well completed July 12 1949
Application for plugging filed July 12 1949
Application for plugging approved July 2 1949
Plugging commenced July 12 1949
Plugging completed July 12 1949
Reason for abandonment of well or producing formation

If a producing well is abandoned, date of last production 19
Was permission obtained from the Conservation Division or its agents before plugging was commenced? yes

Name of Conservation Agent who supervised plugging of this well C.D. Stough
Producing formation Depth to top Bottom Total Depth of Well Feet
Show depth and thickness of all water, oil and gas formations.

OIL, GAS OR WATER RECORDS

CASING RECORD

Formation	Content	From	To	Size	Put In	Pulled Out
				8 5/8"	6-23-49	

Describe in detail the manner in which the well was plugged, indicating where the mud fluid was placed and the method or methods used in introducing it into the hole. If cement or other plugs were used, state the character of same and depth placed, from feet to feet for each plug set.

Filled hole to bottom of surface casing w/ heavy mud; set wood plug @ 225'; cemented w/ 15 sax cement; set wood plug @ 30'; cemented w/ 15 sax cement.

7-18-49

RECEIVED
Conservation Div.
JUL 26 1949
Conservation Division
Wichita, Kan.

(If additional description is necessary, use BACK of this sheet)

Correspondence regarding this well should be addressed to J.D. Ferrell Drilling Co., Inc.,
Address Box 163, Great Bend, Kans.

STATE OF Kansas, COUNTY OF Barton, ss.
J.W. Railsback, Sec. Treas. (employee of owner) or (owner or operator) of the above-described well,
being first duly sworn on oath, says: That I have knowledge of the facts, statements, and matters herein contained and the log of the above-described well as filed and that the same are true and correct. So help me God.

(Signature) J.W. Railsback
Box 163, Great Bend, Kans.
(Address)

SUBSCRIBED AND SWORN to before me this 16th day of July, 1949.

Merk V. Sandefer
Notary Public.

My commission expires Oct. 15, 1951

PLUGGING
FILE SEC 17 T24 R44
BOOK PAGE 105 LINE 25

WELL LOG

J. D. Ferrell Drilg. Co. Inc. & Crown Oil Co. Inc.
 Pioneer #1 Sec.-17; Twp-24S; Rge-11W
 SE NW
 Barton County, Kansas
 Total Depth: 4021'
 Comm: 6-22-49 Comp: 7-12-49
 Contractor: J.D. Ferrell Drilling Co., Inc.
 Issued: 7-15-49 Rotary-C-4021 Elevation: 1032'
 Production: Dry

Casing: 8 5/8" 227' cemented w/ 175
 sex bulk cement - circulated.

Figures Indicate Bottom of Formations:

Cellar	5
sand	115
shale & shells	223
shale & red bed	570
Anhydrite	600
shale	675
shale & shells	1215
shale, shells & salt	1525
lime & shale	1650
lime	1865
lime & shale	1900
lime	2100
bro. lime	2200
shale & shells	2340
shale & lime	2940
lime	3489
Cherty lime	3553
lime	3587
Cherty lime	3655
lime	3705
lime & shale	3825
Viola lime	3831
lime	3930
lime & shale	3900
shale	4006
Arbuckle	4021
Total Depth	4021

Tops:	
Lansing	3480
Kinderhook	3752
Viola	3825
Simpson shale	3947
Simpson Sand	3967
Arbuckle	4000
Total Depth	4021

We hereby certify this to be a correct and accurate log of the
 above described well as shown on the daily Drilling Reports.

J.D. FERRELL DRILLING COMPANY, INC.

By: J. D. Ferrell

Subscribed and sworn to before me this 15th day of July, 1949.

My Commission Expires:

10-15-51

Merle V. Sandberg
 Notary Public

*File copy
 7 - Sinclair Prairie
 1 - Kansas Geological Survey*

