


STATE OF KANSAS
STATE CORPORATION COMMISSION

WELL PLUGGING RECORD

Give All Information Completely
Make Required Affidavit
Mail or Deliver Report to
Conservation Division
State Corporation Comm.
245 North Water
Wichita, KS 67202

Edwards County. Sec. 3 Twp. 24S Rge. 18W E/W
Location as "NE/CNW $\frac{1}{4}$ SW $\frac{1}{4}$ " or footage from lines
NW SE SW
Lease Owner F & M OIL CO., INC.
Lease Name Britton Well No. 1
Office Address 422 Union Center, Wichita, Kansas 67202
Character of Well (Completed as Oil, Gas or Dry Hole)

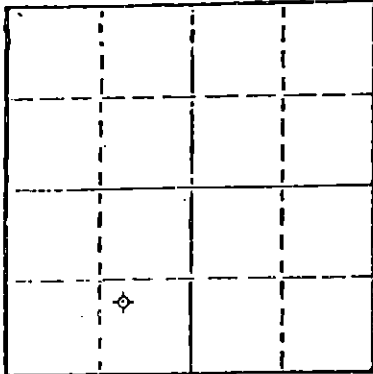

Locate well correctly on above
Section Plat

Dry
Date Well completed August 31, 1982
Application for plugging filed August 31, 1982
Application for plugging approved August 31, 1982
Plugging commenced August 31, 1982
Plugging completed August 31, 1982
Reason for abandonment of well or producing formation
Dry

If a producing well is abandoned, date of last production 19
Was permission obtained from the Conservation Division or
its agents before plugging was commenced? Yes

Name of Conservation Agent who supervised plugging of this well Paul Luthi
Producing formation Depth to top Bottom Total Depth of Well 4620'
Show depth and thickness of all water, oil and gas formations.

OIL, GAS OR WATER RECORDS

CASING RECORD

FORMATION	CONTENT	FROM	TO	SIZE	PUT IN	PULLED OUT

Describe in detail the manner in which the well was plugged, indicating where the mud fluid
was placed and the method or methods used in introducing it into the hold. If cement or other
plugs were used, state the character of same and depth placed, from _____ feet to
_____ feet for each plug set.

Set 1st plug @ 840' w/60 sxs
Set 2nd plug @ 450' w/50 sxs
Set 3rd plug @ 40' w/10 sxs
10 sxs in the rat hole, 5 sxs in the water well
plug down @ 10:30 am 8-31-82

(If additional description is necessary, use BACK of this sheet)

Name of Plugging Contractor _____

STATE OF Kansas COUNTY OF Sedgwick, ss.
R. D. Messinger (employee of owner) or (owner or operator)
of the above-described well, being first duly sworn on oath, says: That I have knowledge of
the facts, statements, and matters herein contained and the log of the above-described well
as filed and that the same are true and correct. So help me, God.

(Signature) [Signature]
422 Union Center, Wichita, Ks. 67202
(Address)

SUBSCRIBED AND SWORN TO before me this 8th day of September, 19 82

My commission expires 12-24-84

[Signature]
Shirley A. Gallegos
Notary Public.



RECEIVED
STATE CORPORATION COMMISSION

SEP 10 1982

CONSERVATION DIVISION
Wichita, Kansas

CONTRACTOR'S WELL LOG

OPERATOR:	F & M OIL CO., INC.
CONTRACTOR:	Union Drilling Co., Inc.
LEASE NAME:	Britton #1
LOCATION:	NW SE SW Section 3-24S-18W Edwards County, Kansas
COMMENCED:	August 21, 1982
COMPLETED:	August 31, 1982

0	467	Sand & clay
467	4005	Shale
4005	4119	Shale & lime
4119	4125	Lime
4125	4356	Lime & shale
4356	4482	Lime
4482	4525	Chert
4525	4620	Lime & shale
4620	4620	Lime
4620		RTD

We certify that the above foregoing is a true and correct copy of the log on the Britton #1, NW SE SW Section 3-24S-18W, Edwards County, Kansas.

Union Drilling Co., Inc.

R. D. Messinger

 R. D. Messinger

STATE OF KANSAS)
) SS
 COUNTY OF SEDGWICK)

Subscribed and sworn to before me, a Notary Public in and for the aforesaid County and State as of this 8th day of September, 1982.

My appointment expires:

 12-24-84

Shirley A. Gallegos

 Shirley A. Gallegos-Notary Public



RECEIVED
 STATE CORPORATION COMMISSION
 SEP 10 1982
 CONSERVATION DIVISION
 Wichita, Kansas