


STATE OF KANSAS
STATE CORPORATION COMMISSION
CONSERVATION DIVISION
P. O. BOX 17027
WICHITA, KANSAS 67217

FORM CP-4

WELL PLUGGING RECORD

Edwards County, Sec. 36 Twp. 24S Rge. (E) 17 (W)
C SE NW

Location as "NE/CNW/SE/SW" or footage from lines
Lease Owner White & Ellis Drilling, Inc.
Lease Name Wheaton Well No. 1
Office Address 7701 E. Kellogg, Suite 290, Wichita, Kansas
Character of Well (completed as Oil, Gas or Dry Hole) Dry Hole 67207
Date well completed May 19, 1978
Application for plugging filed May 19, 1978
Application for plugging approved May 19, 1978
Plugging commenced May 19, 1978
Plugging completed May 19, 1978
Reason for abandonment of well or producing formation Dry Hole

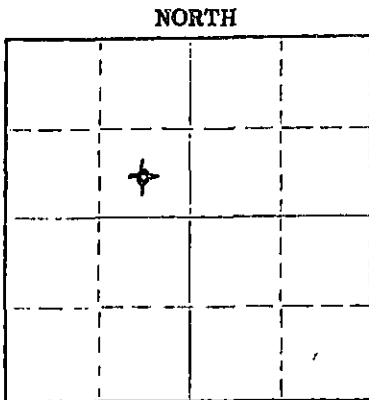

Locate well correctly on above Section Plat

If a producing well is abandoned, date of last production _____ 19____
Was permission obtained from the Conservation Division or its agents before plugging was commenced? Yes

Name of Conservation Agent who supervised plugging of this well _____
Producing formation _____ Depth to top _____ Bottom _____ Total Depth of Well 4547 Feet
Show depth and thickness of all water, oil and gas formations.

OIL, GAS OR WATER RECORDS

CASING RECORD

FORMATION	CONTENT	FROM	TO	SIZE	PUT IN	FULLED OUT
		0'	335'	8-5/8"	328.72'	0'

Describe in detail the manner in which the well was plugged, indicating where the mud fluid was placed and the method or methods used in introducing it into the hole. If cement or other plugs were used, state the character of same and depth placed, from _____ feet to _____ feet for each plug set.

Plug at 600' with 40 sacks cement,
35 sacks cement at 360', set plug
at 40' with 12 sacks cement, 2 sacks
cement in rat hole.

RECEIVED
JUN 01 1978
CONSERVATION DIVISION
WICHITA, KANSAS

(If additional description is necessary, use BACK of this sheet)
Name of Plugging Contractor Halliburton Services 6-1-78
Address Pratt, Kansas

STATE OF KANSAS COUNTY OF SEDGWICK ss.
John H. Knightley, Agent (employee of owner) or (owner or operator) of the above-described well, being first duly sworn on oath, says: That I have knowledge of the facts, statements, and matters herein contained and the log of the above-described well as filed and that the same are true and correct. So help me God.

(Signature) John H. Knightley
221 S. Broadway, Suite 400, Wichita,
Kansas (Address)

SUBSCRIBED AND SWORN TO before me this 31st day of May, 19 78

My commission expires July 17, 1980

[Signature]
Notary Public.

White & Ellis Drilling, Inc. - Wheaton #1
 C SE NW Sec. 36-245-17W
 Edwards County, Kansas

Contractor: D. R. Lauck Oil Company, Inc.
 221 S. Broadway, Suite 400
 Wichita, Kansas 67202

Commenced: May 9, 1978
 Completed: May 19, 1978

Drillers Log

Shale	134
Sand	190
Shale	375
Red Bed	599
Sand	609
Red Bed	1337
Anhydrite	1360
Shale	2055
Shale & Lime	3630
Lime & Shale	3795
Shale & Lime	3980
Lime	4185
Shale & Lime	4325
Lime	4547 TD

RECEIVED
 STATE CORPORATION COMMISSION
 JUN 01 1978
 CONSERVATION DIVISION
 Wichita, Kansas